


T.6S.,R.6W.,W.M.

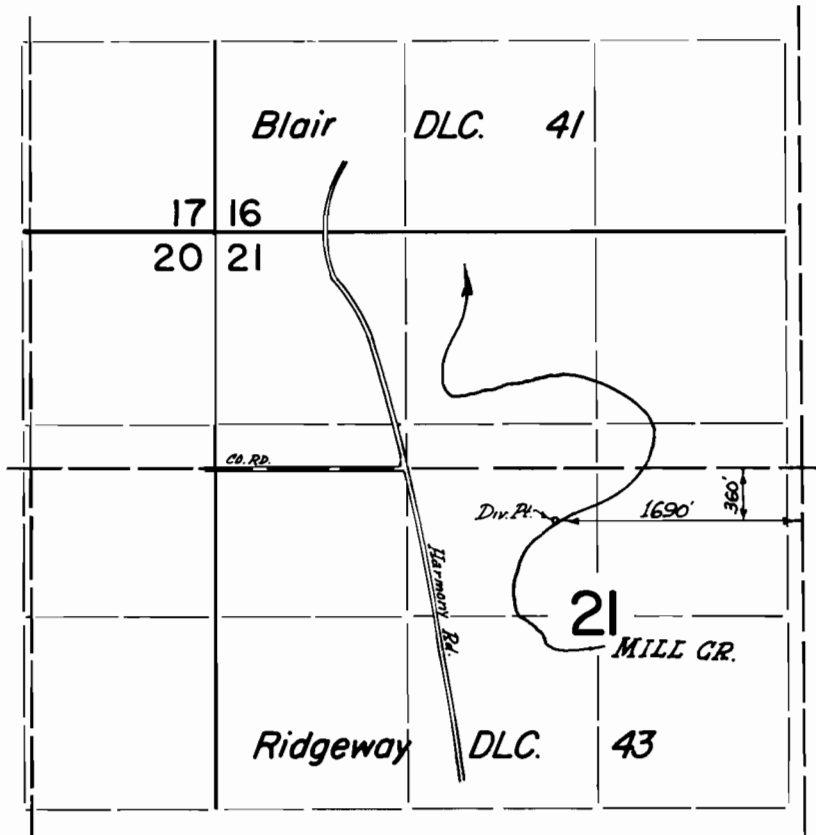

FINAL PROOF SURVEY
UNDER

Transfer Nos. 3217, 3218, 3219, & 3220

Application No. Permit No.

IN NAME OF

..... **GEORGE J. & HERTA L. RIGGS**

Surveyed *Aug. 8*..... 19*77*., by *L.M. Tott*.....