


T.38S., R.4W., W.M.

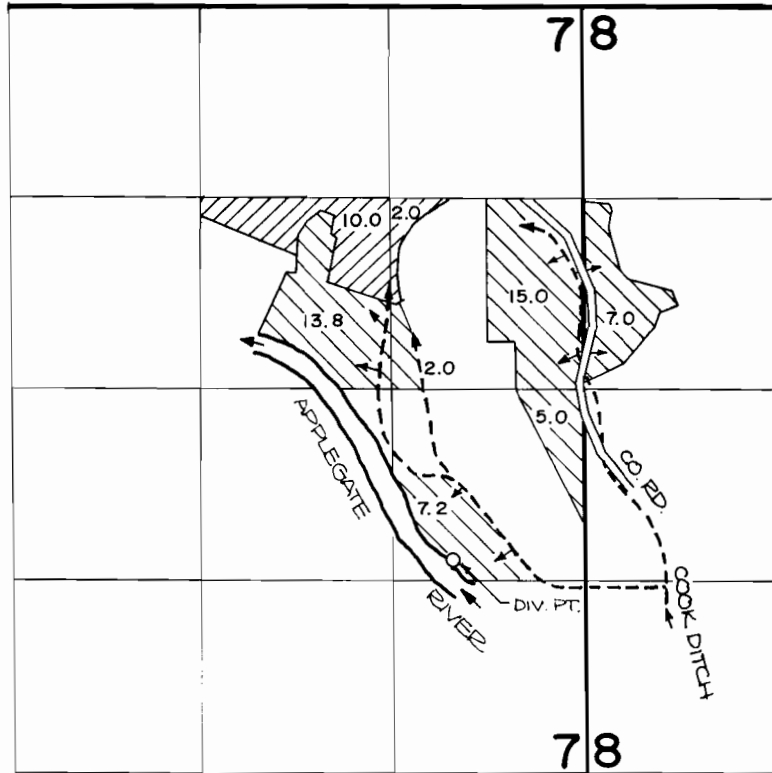

DIVERSION POINT IS LOCATED 1310' S. AND 880' W. FROM THE E. 1/4 CORNER OF SECTION 7.



PRIMARY



SUPPLEMENTAL

FINAL PROOF SURVEY

UNDER

TRANSFER NO. 3222

Application No. 61968... Permit No. 46304.....

IN NAME OF

KROUSE RANCH, INC.

JULY 26 1983 B. JAMES

Surveyed APR. 22. 1982. by B. SUND.....