


# T.14S. R.5W.W.M.

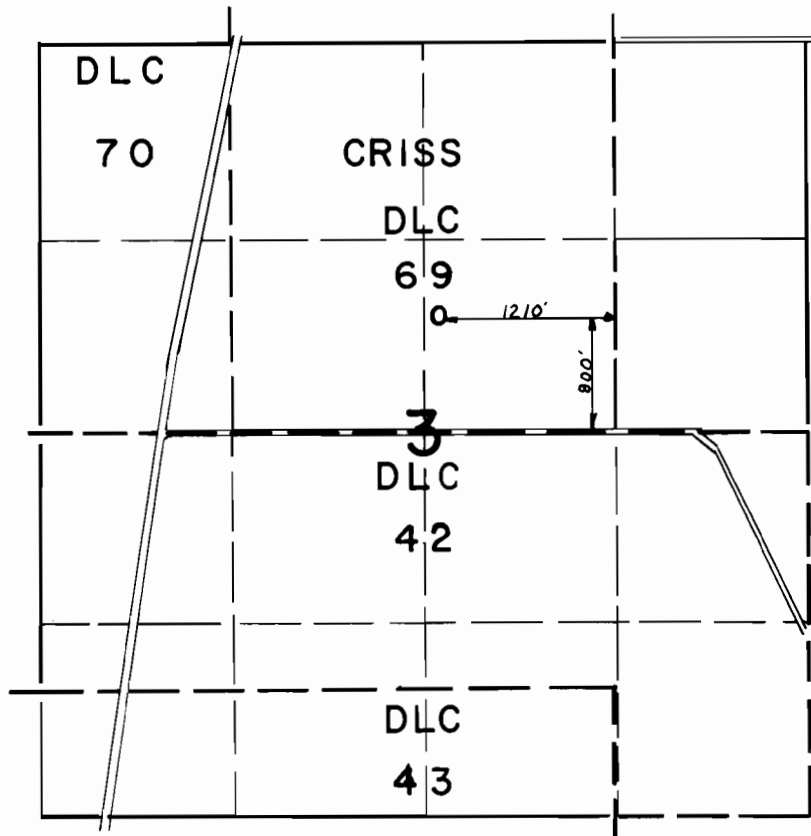

## FINAL PROOF SURVEY UNDER

Transfer NO. 3223  
Application No. .... Permit No. ....  
IN NAME OF

**EARL FRANKLIN**

Surveyed OCT. 5, 1976, by C.R. KING