


T. 39 S., R. 2 W., W.M.

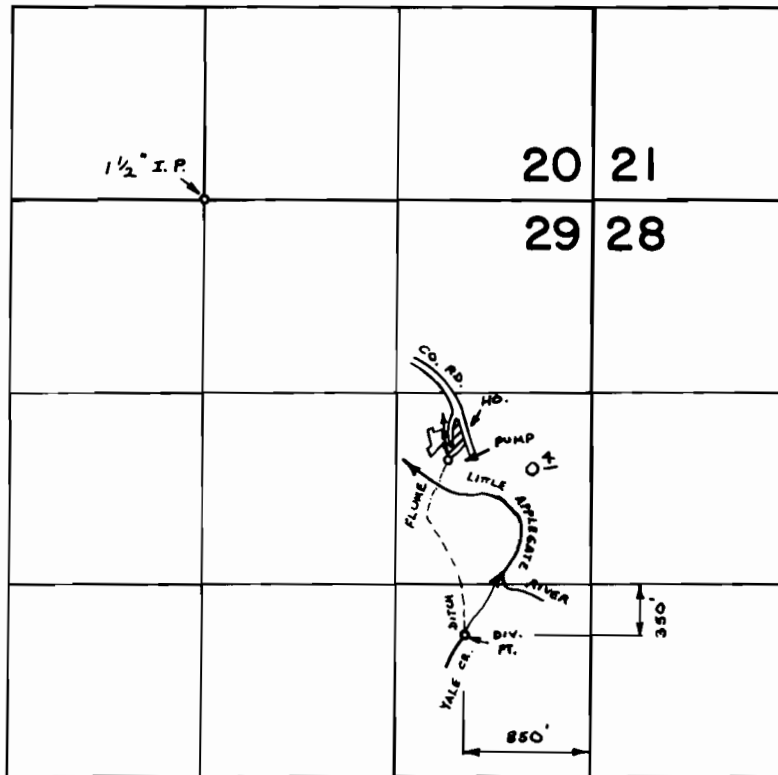

**FINAL PROOF SURVEY**  
UNDER

Transfer No. 3225

Application No. .... Permit No. ....

IN NAME OF

**HARVEY W. ROBERTSON**

Surveyed OCT. 9 1978, by B. SUND

D.H.M.  
P.T.S. - 1978-14-D