


T.6S.,R.6W.,W.M.

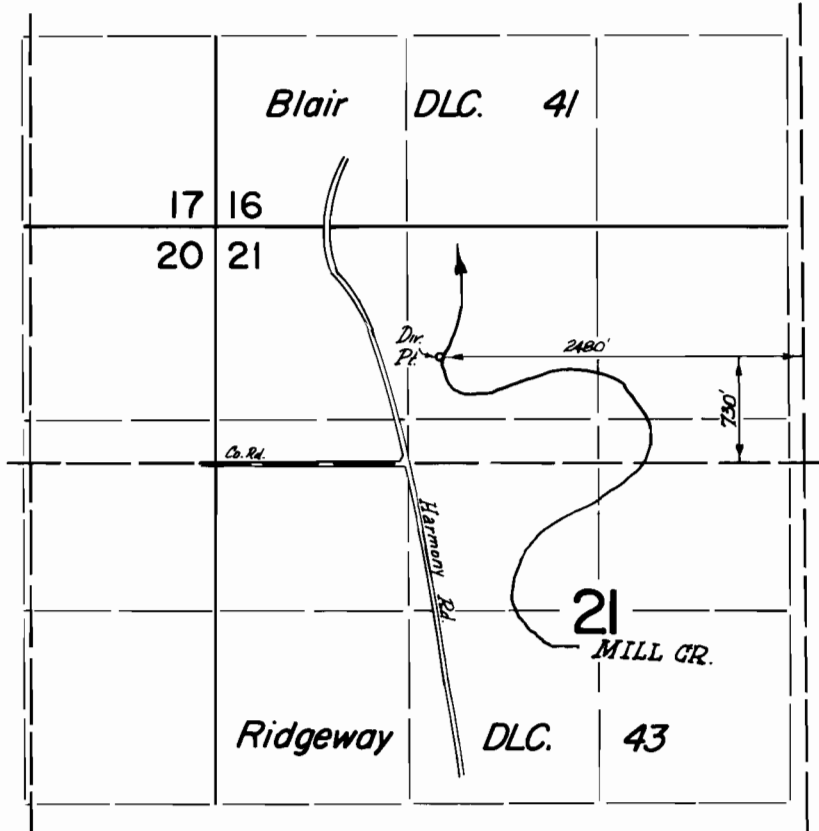

FINAL PROOF SURVEY
UNDER

Transfer No. 3227

Application No. Permit No.

IN NAME OF

..... WILLIAM G. & JOY L. STUIVENGA

Surveyed *Aug. 8* 19*77* .. by *L.M. Tall*