


T.14&15S. R.11E. W.M.

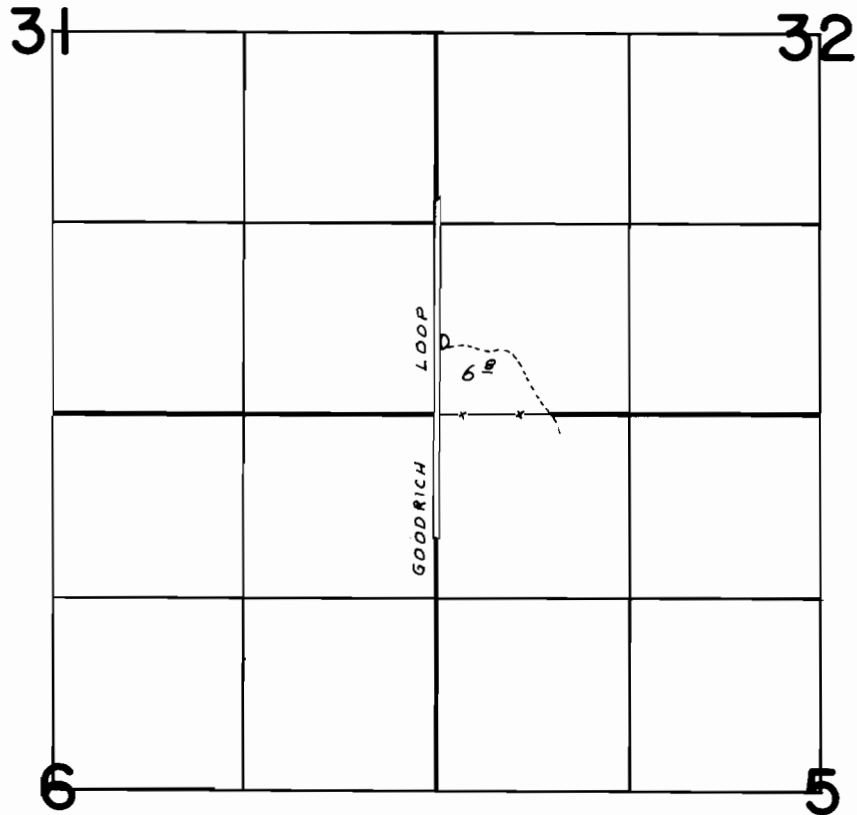

FINAL PROOF SURVEY
UNDER

TRANSFER NO. 3234

Application No. Permit No.

IN NAME OF

JAMES D. ROGERS

Surveyed APR. 18. 1980., by L.H. NUNN