


T.18S. R.12E. W.M.

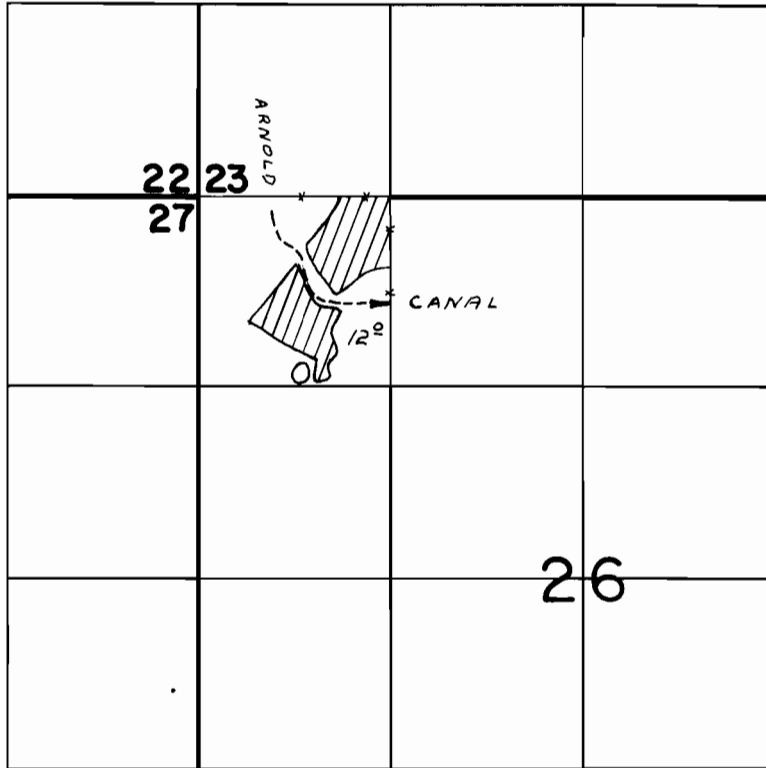

FINAL PROOF SURVEY
UNDER

TRANSFER NO. 3242
Application No. Permit No.
IN NAME OF

FRANK GILCHRIST

Surveyed JULY 22, 1980, by L.H. NUNN