


# T.17S., R.12E., W.M.

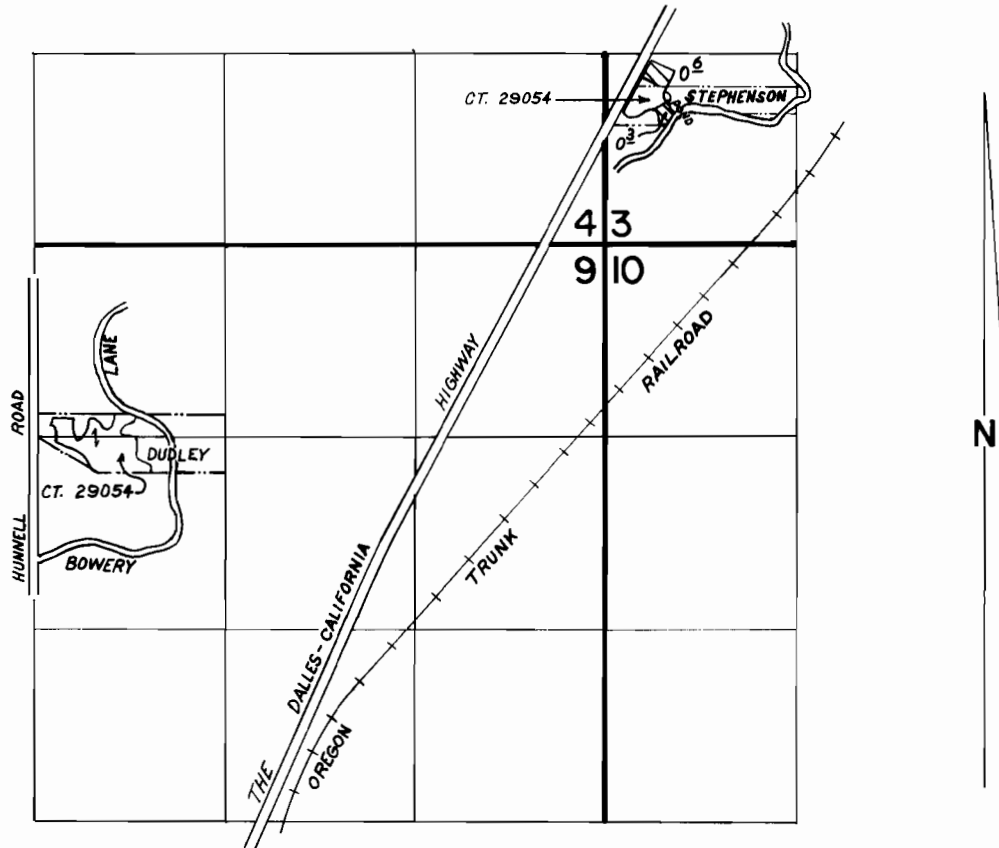

SCALE: 1" = 1320'

## FINAL PROOF SURVEY UNDER

TRANSFER NO. 3262  
Application No. .... Permit No. ....  
IN NAME OF

GEORGE STEPHENSON & JAMES DUDLEY/DR.I.C.

Surveyed MAY 29 19 84, by LESLIE OLSON...