


T. I. N. R. I. O. E. W. M.

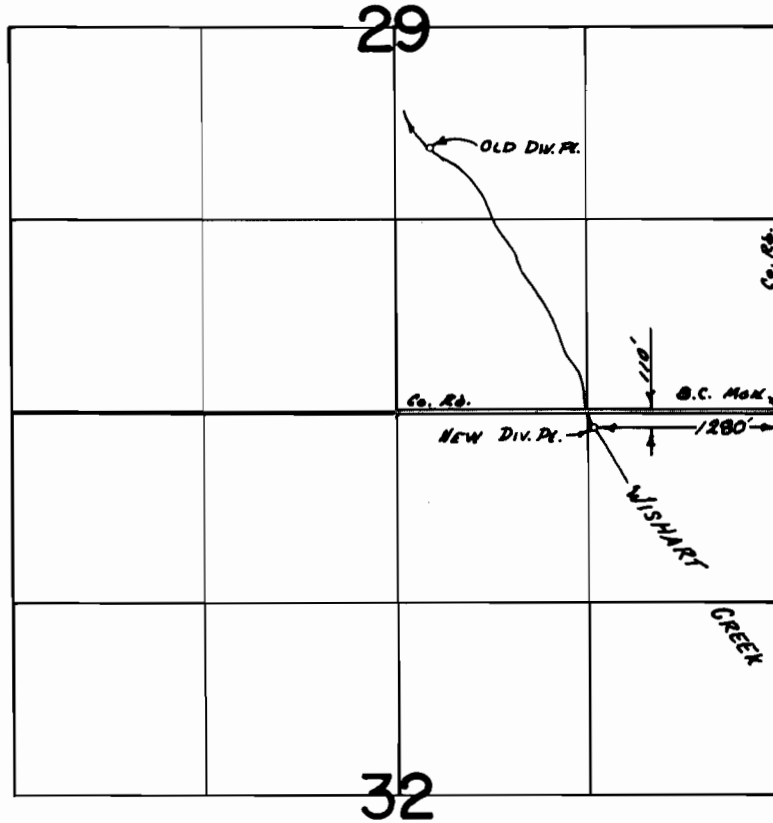

RECEIVED

JUNE 1 1975
STATE ENGINEER
SALVAGE DIVISION

MIDDLE FORK IRRIGATION DISTRICT

Map of new diversion from Wishart Creek

Surveyed 6-3-75
by T. PAUL

T-3264