


T. 39S. R. 2E. W. M.

19

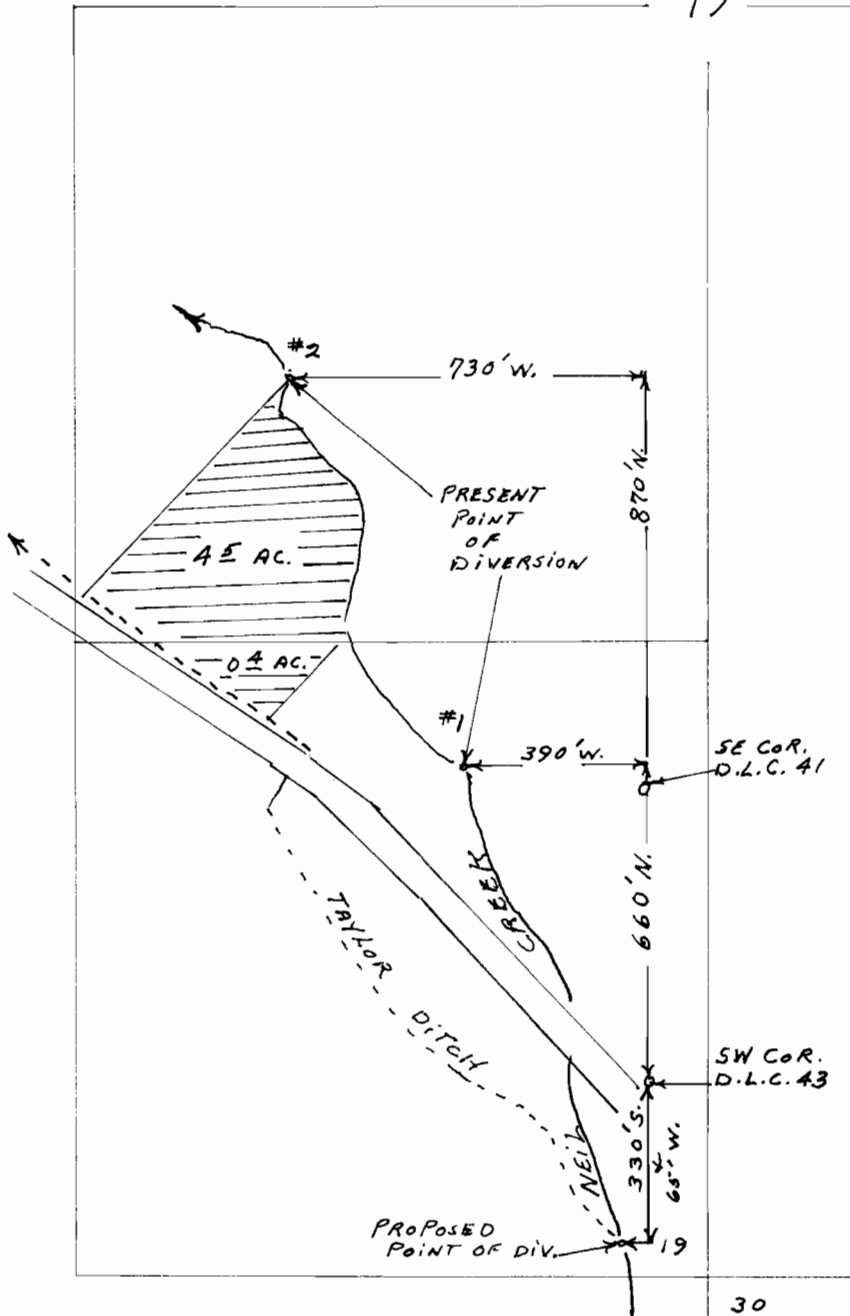

MAP TO ACCOMPANY APPLICATION OF
JERRY W. AND CATHERINE A. EVITTS FOR
CHANGE IN POINT OF DIVERSION



6-25-75