


T.3S. R.9W. W.M.

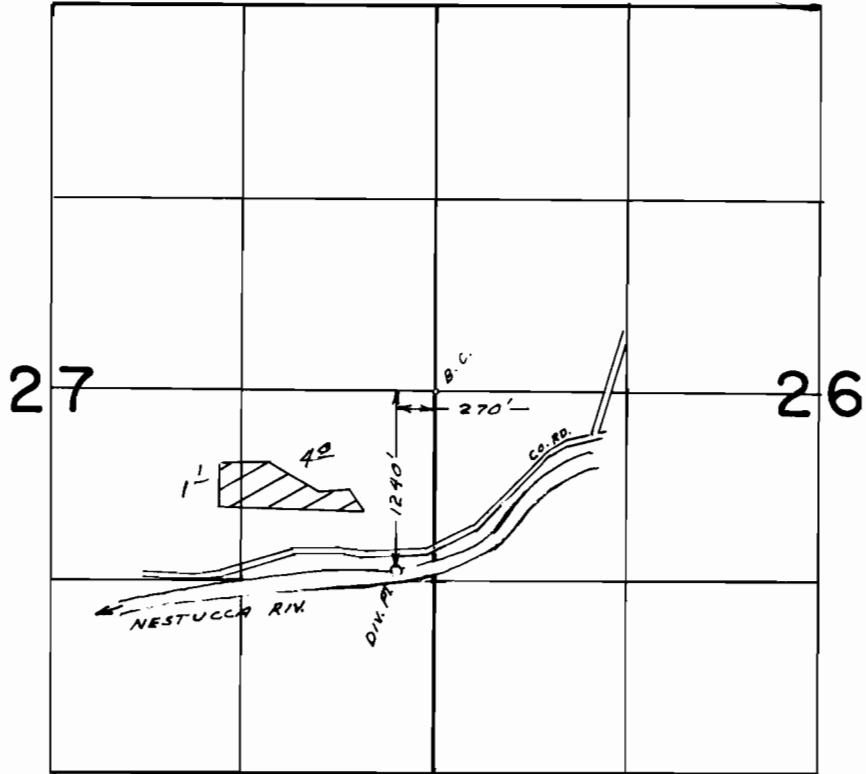

FINAL PROOF SURVEY
UNDER

TRANSFER NO. 3273

Application No. Permit No.

IN NAME OF

.....
NEWTON L. & PEGGY J. KINKADE
.....

Surveyed AUG. 3. 1977, by L.H. NUNN.....