


T. 3S., R. 4W., W.M.

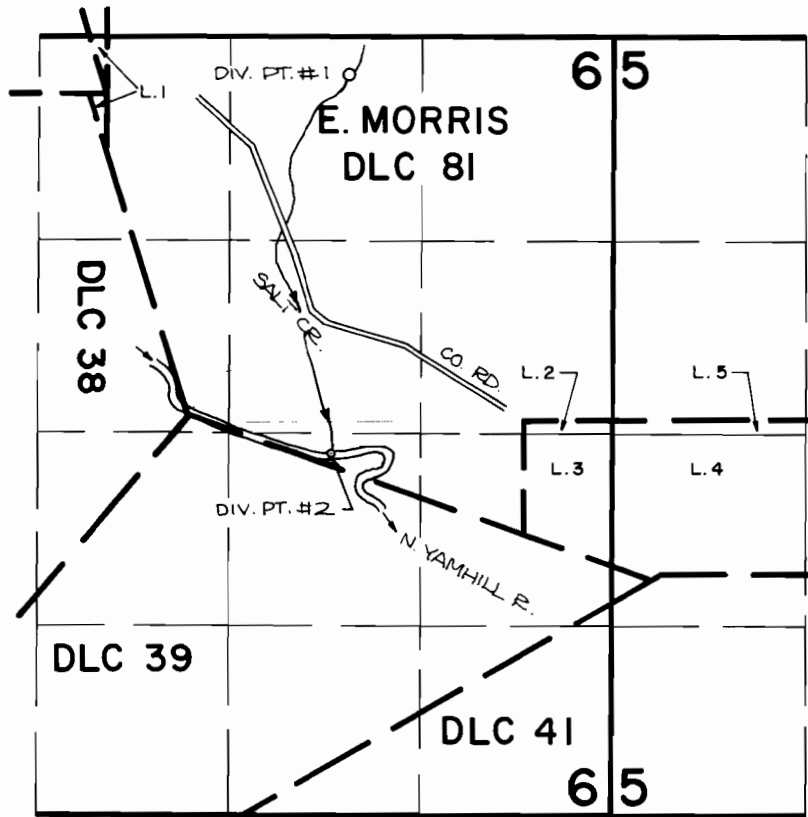

DIV. PT. #2 LOCATION: 175 FT. N. AND 1,350 FT. W.;  
DIV. PT. #1 LOCATION: 2340 FT. N. AND 1,210 FT. W.; BOTH FROM  
THE N. W. CORNER OF LOT 2 (SE of NE)



SCALE: 4" = 1 MILE

**FINAL PROOF SURVEY**  
UNDER

TRANSFER NO. 3278

IN NAME OF

**ROLLIE & TED MORRIS**

Surveyed JULY 10, 1984, by *P. Patten*