


T. 39 S., R. 3 W., W.M.

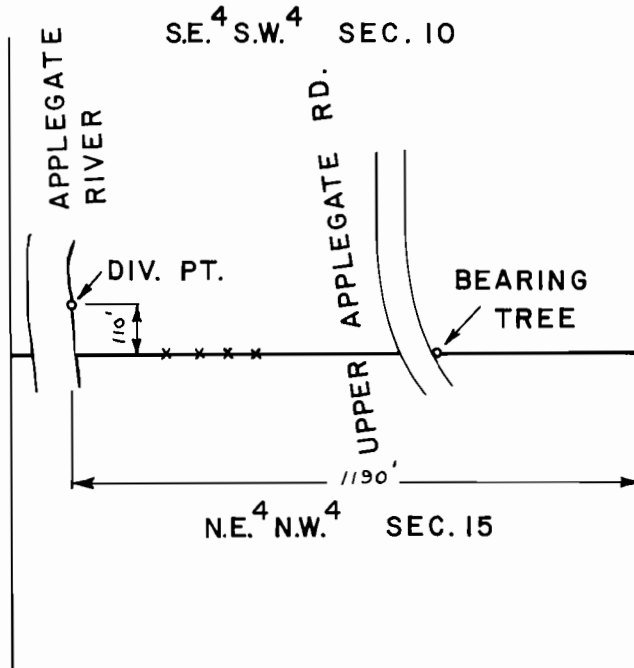

SCALE : 1" = 400 FT.

FINAL PROOF SURVEY UNDER

Transfer No. 3283

Application No. Permit No.
IN NAME OF

DION A. & GLENNA WHEELIS

Surveyed APR. 24 1979, by B. SUND

D.H.M.
P.T.S. -1979-14-A