


T. 30S., R 4 W., W.M.

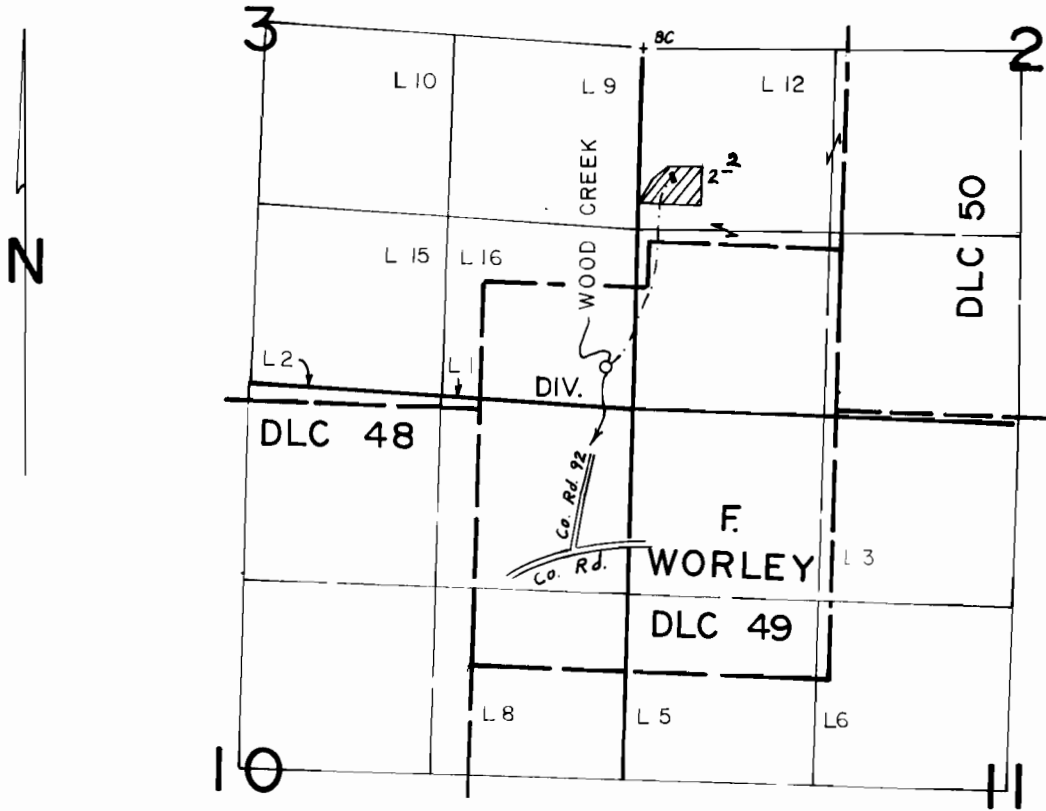

DIV. PT. LOC. 280' N. and 190' W. FROM SE COR. SEC 3.

SCALE: 4" = 1 mile

**FINAL PROOF SURVEY**  
UNDER

T - 3287  
T - 4023

Application No. .... Permit No. ....

IN NAME OF

**ERNEST A. & LILLIE L. WAGNER**

Surveyed AUG. 22, 1983, by J.S. DONALDSON