


T.2S.R.1W.W.M.

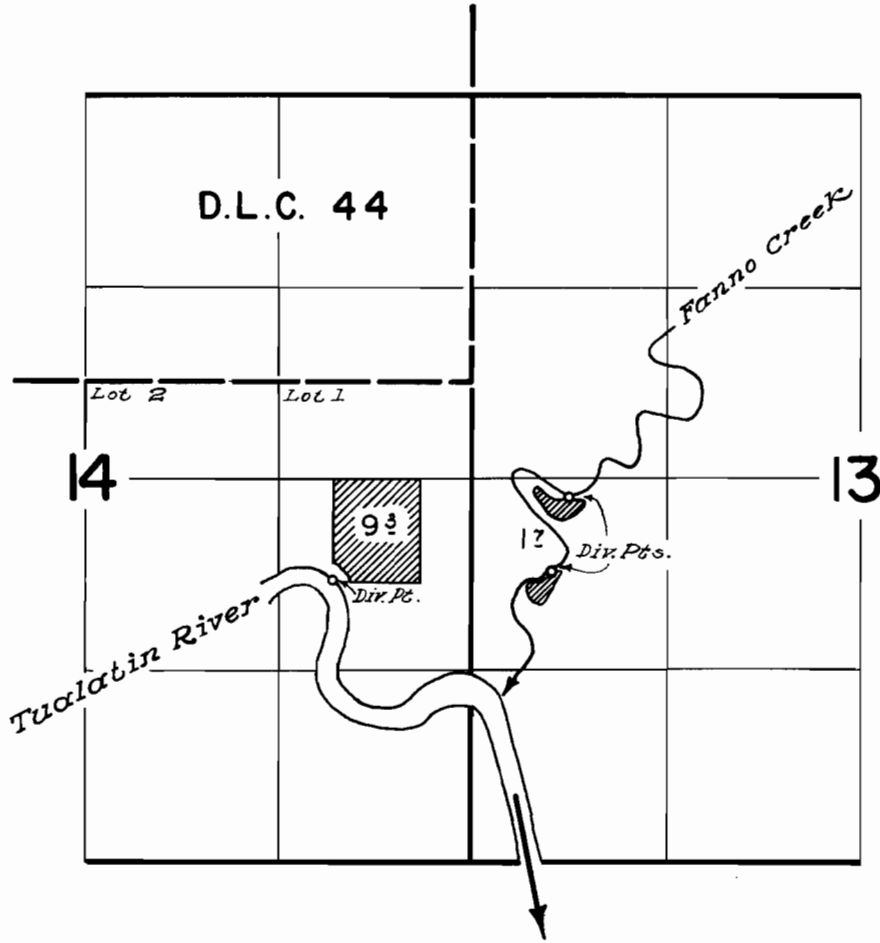

FINAL PROOF SURVEY
UNDER

Application No. 30.11.7... Permit No. 23.7.7.1
IN NAME OF

HENRY S. MEARS

Surveyed May 23, 1960, by *[Signature]*