


T. 1 S., R. 10 E., W.M.

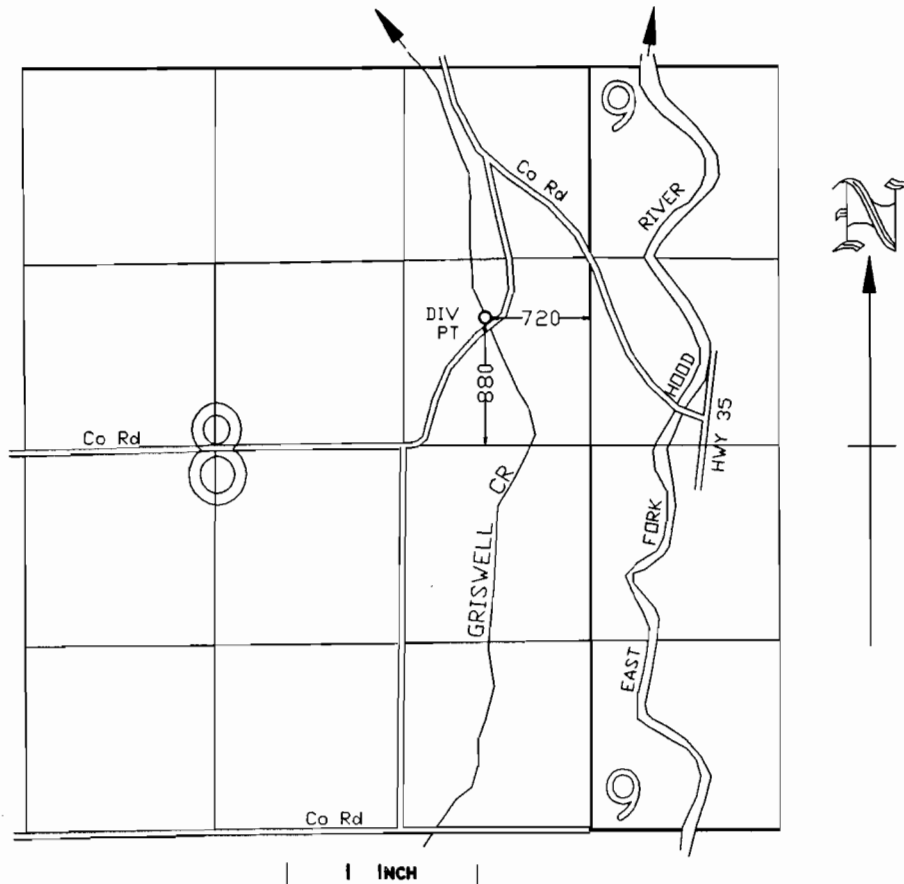

SCALE: 1 INCH = 1320 FEET

FINAL PROOF SURVEY
UNDER

TRANSFER APPLICATION No. 3303
IN NAME OF

MIDDLE FORK IRRIGATION DISTRICT

SURVEYED JUNE, 1980, BY R.G. MUCKEN AND L.M. TOLL