


T.2S., R.44E., W.M.

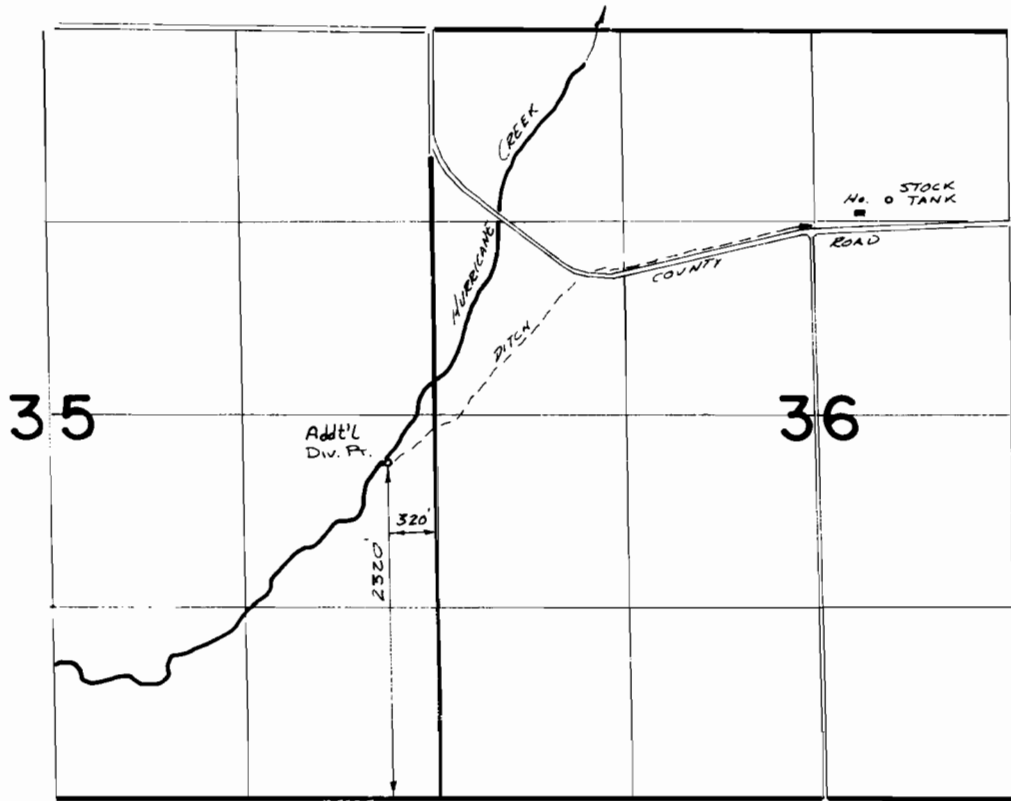

FINAL PROOF SURVEY

UNDER

TRANSFER 3321

IN NAME OF

.....SYLVIA.....BONER.....

Surveyed ~~8-23~~ 19~~78~~⁷⁹, by ~~P. Bonner~~
8-10 82 V.L. Church