


T.23S.,R.7W.,W.M.

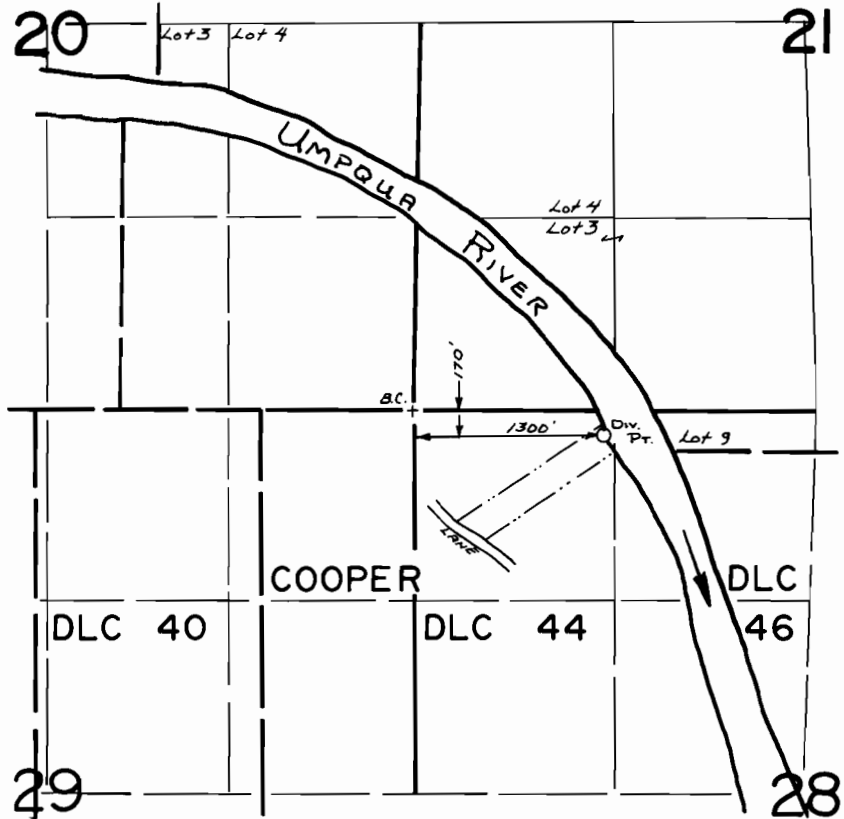

**FINAL PROOF SURVEY**  
UNDER

Transfer No. 3323  
Application No. .... Permit No. ....  
IN NAME OF

PERCY V. PAYTON

Surveyed APR. 21, 1977, by L.H. NUNN

23S 7W SW/4  
BTR-244-97  
1977-P