


T. 4N. R. 28E. W.M.

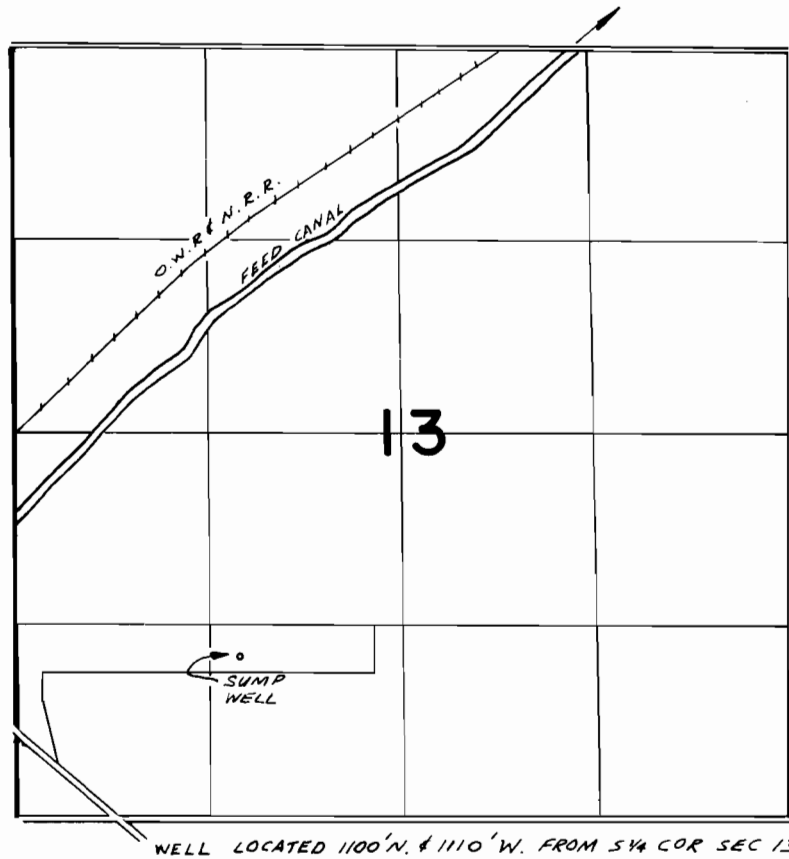

FINAL PROOF SURVEY UNDER

TRANSFER 3327

Application No. Permit No.
IN NAME OF

..... CECIL D. THOMPSON

Surveyed 11-30 1977, by R. BARWIN