


# T. 1N., R. 27E., W.M.

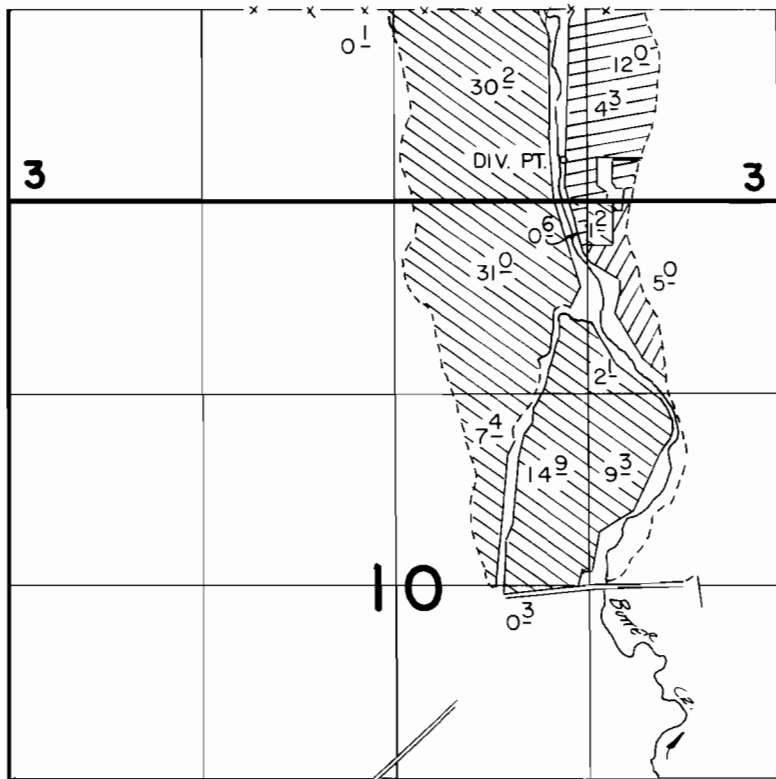




DIV. PT. LOCATED 280' N. & 1150' E. FROM 1/4 COR. SEC. 3

## FINAL PROOF SURVEY UNDER

**TRANSFER 3333**  
IN NAME OF

.....**EARL WATTENBURGER**.....

Surveyed 10-23..... 1985., by V.L. CHURCH.....

-  -1896
-  -1890
-  -1872

SCALE: 1" = 1320'