
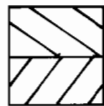


# T.15 & 16S. R.14E. W.M.

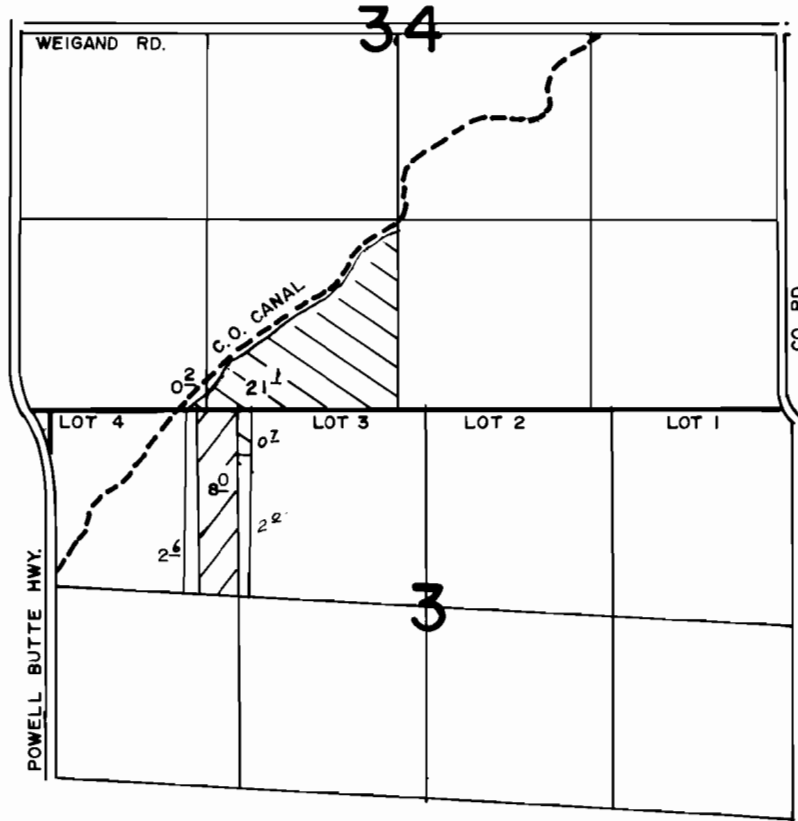

T. 3334

T. 4005

## FINAL PROOF SURVEY UNDER

TRANSFER NO. 3334 & 4005

Application No. .... Permit No. ....

IN NAME OF

**JAMES L. BUSSETT**

Surveyed MAY 22, 1980, by L.H. NUNN