
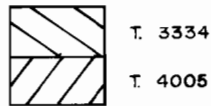


T.15 & 16S. R.14E. W.M.

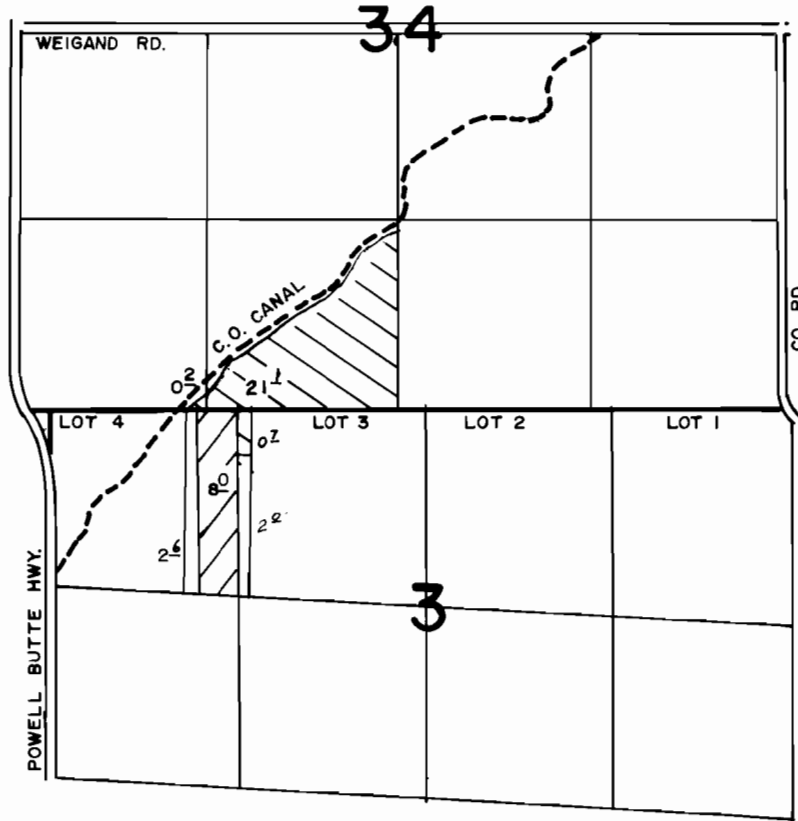

FINAL PROOF SURVEY UNDER

TRANSFER NO. 3334 & 4005

Application No. Permit No.

IN NAME OF

JAMES L. BUSSETT

Surveyed MAY 22, 1980, by L.H. NUNN