


T.11S. R.2W. W.M.

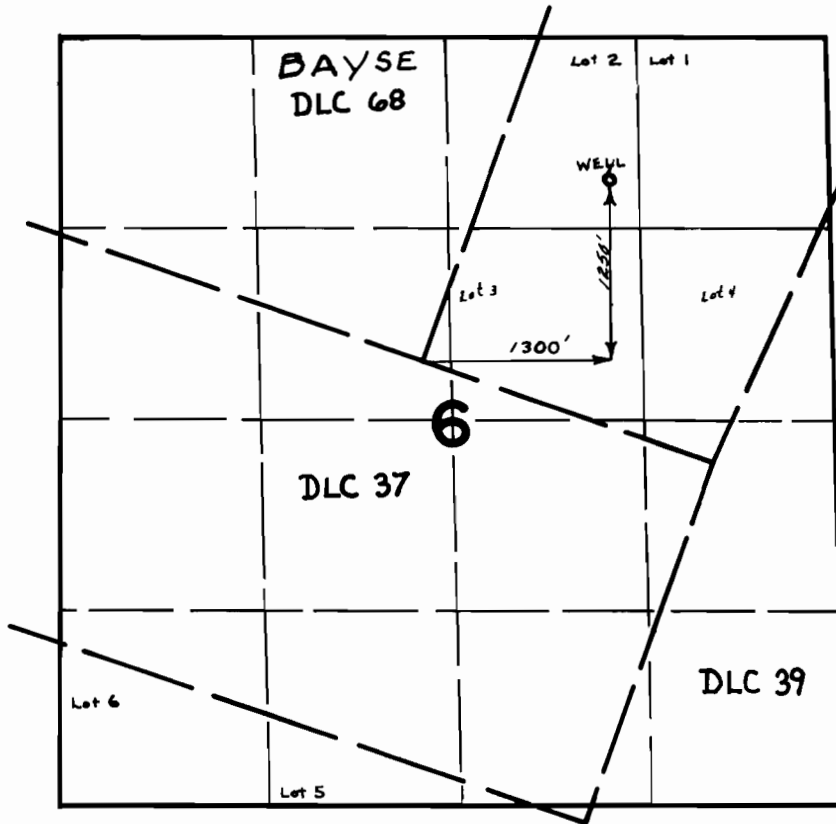

FINAL PROOF SURVEY
UNDER

Transfer No. 3342
IN NAME OF

SCHELER CORPORATION

Surveyed AUG. 10, 1977, by D. NORBY