


T. 37S., R. 6 W., W.M.

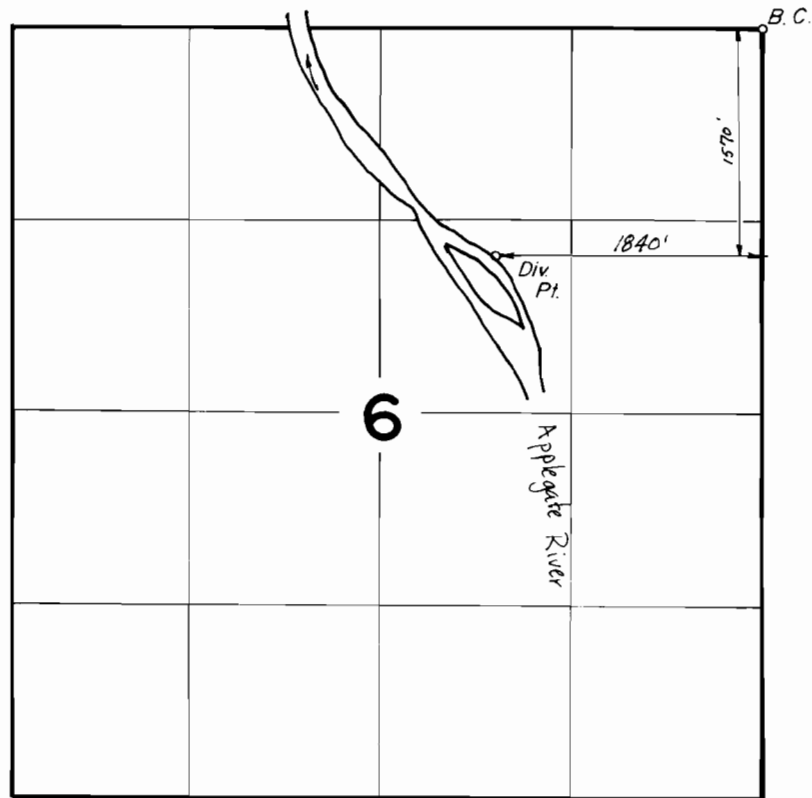

FINAL PROOF SURVEY
UNDER

TRANSFER NO. 3343

IN NAME OF

MARY KATHRYN SHANKS

Surveyed AUG. 11, 1982, by B. S. JAMES