


T.5S., R.7W., W.M.

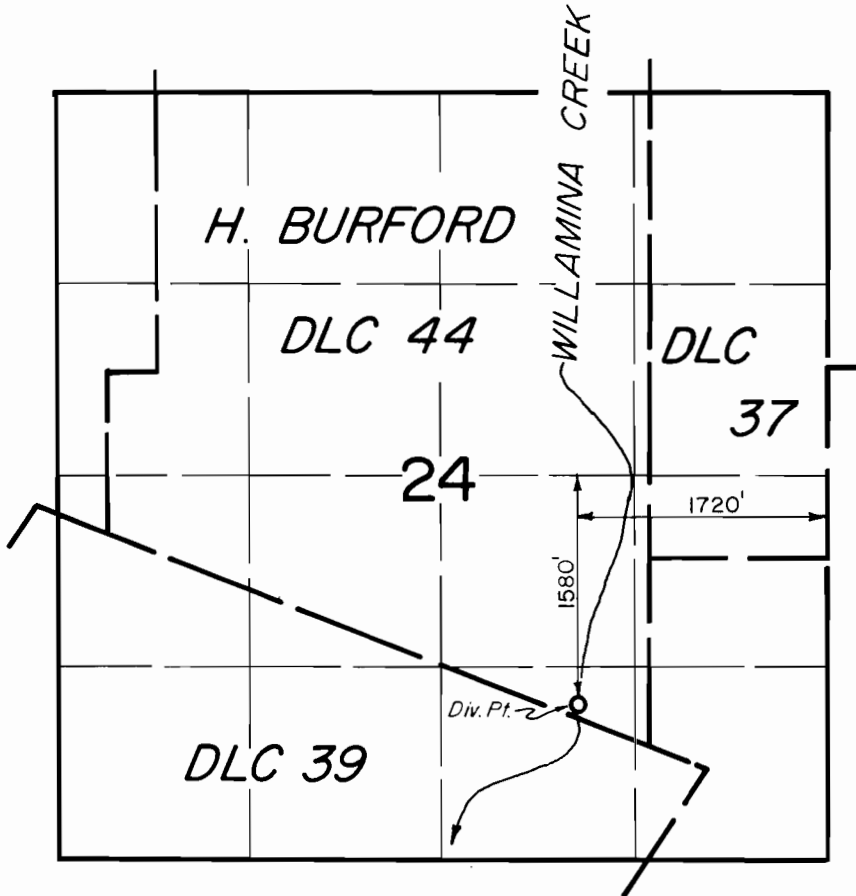

FINAL PROOF SURVEY
UNDER

TRANSFER NO. 3347
IN NAME OF

David E. Fendall

Surveyed AUG. 20, 19.79, by *[Signature]*