


T-3363

RECEIVED
FEB 13 1976
WATER RESOURCES DEPT.
SALEM, OREGON

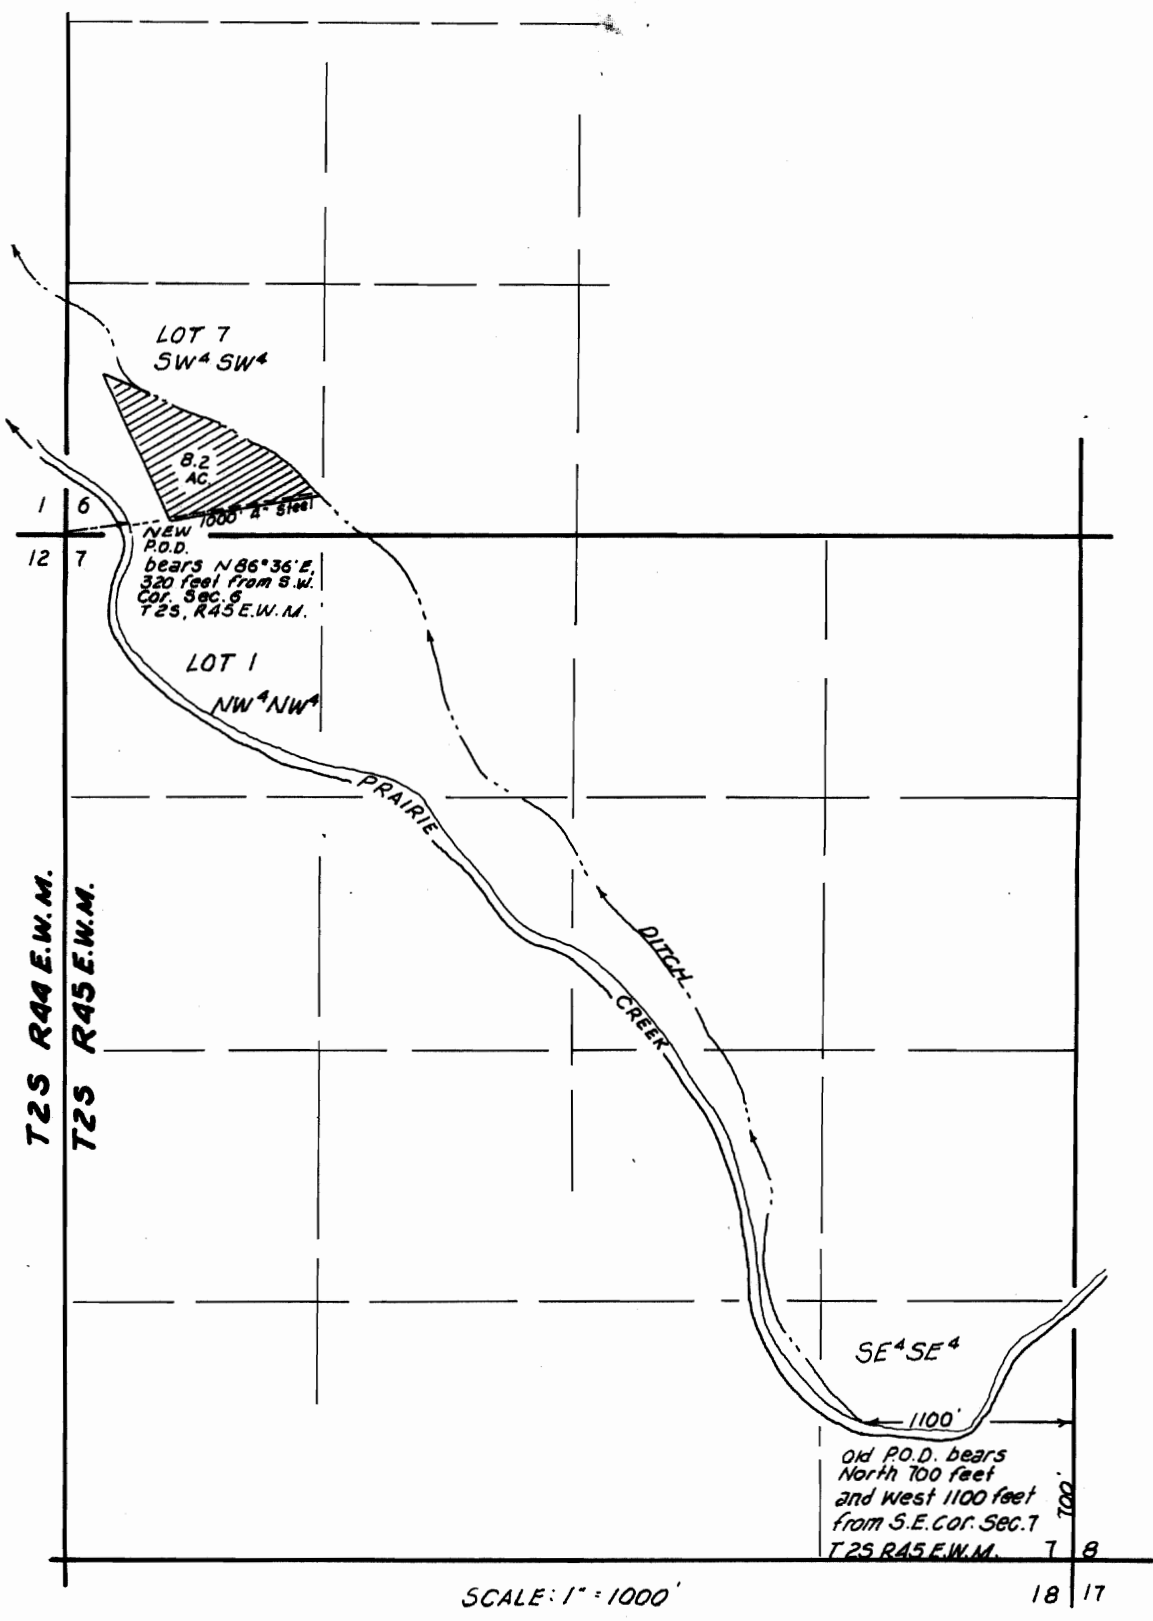

Prepared for Dick Ingle and John Hillock
 By: Verne H. Russell - Oregon PLS No. 427
 Date: 1-24-76

REGISTERED
 PROFESSIONAL
 LAND SURVEYOR

Verne H. Russell

OREGON
 OCTOBER 4, 1957
 VERNE H. RUSSELL
 4 2 7