


T. 40 S., R. 8 W., W.M.

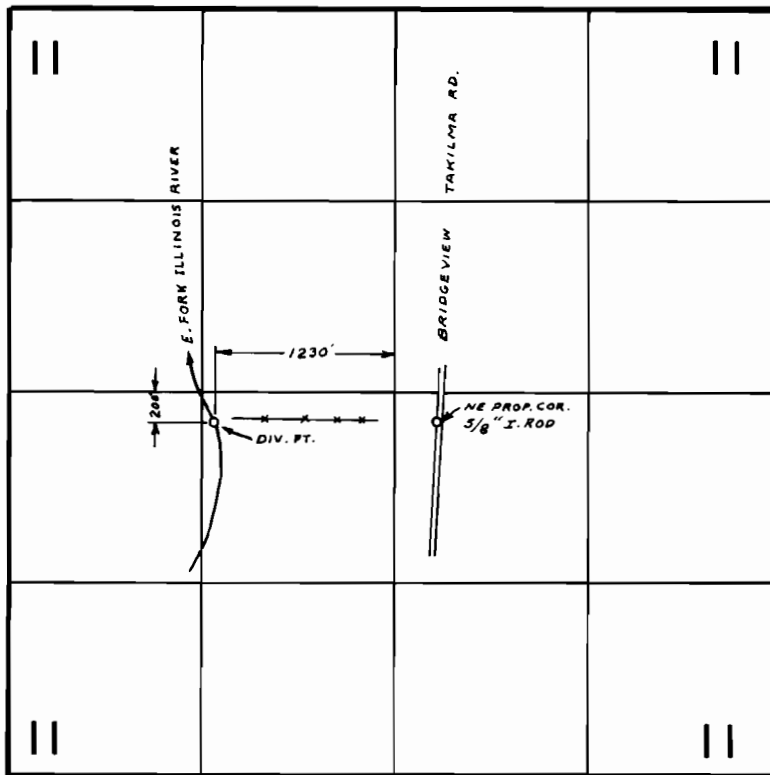

FINAL PROOF SURVEY UNDER

Transfer No. 3376

Application No. Permit No.

IN NAME OF

JOHN L. IKER

Surveyed AUG. 7 78 by B. SUND
..... 19....., by