


T.23S. R.7W. W.M.

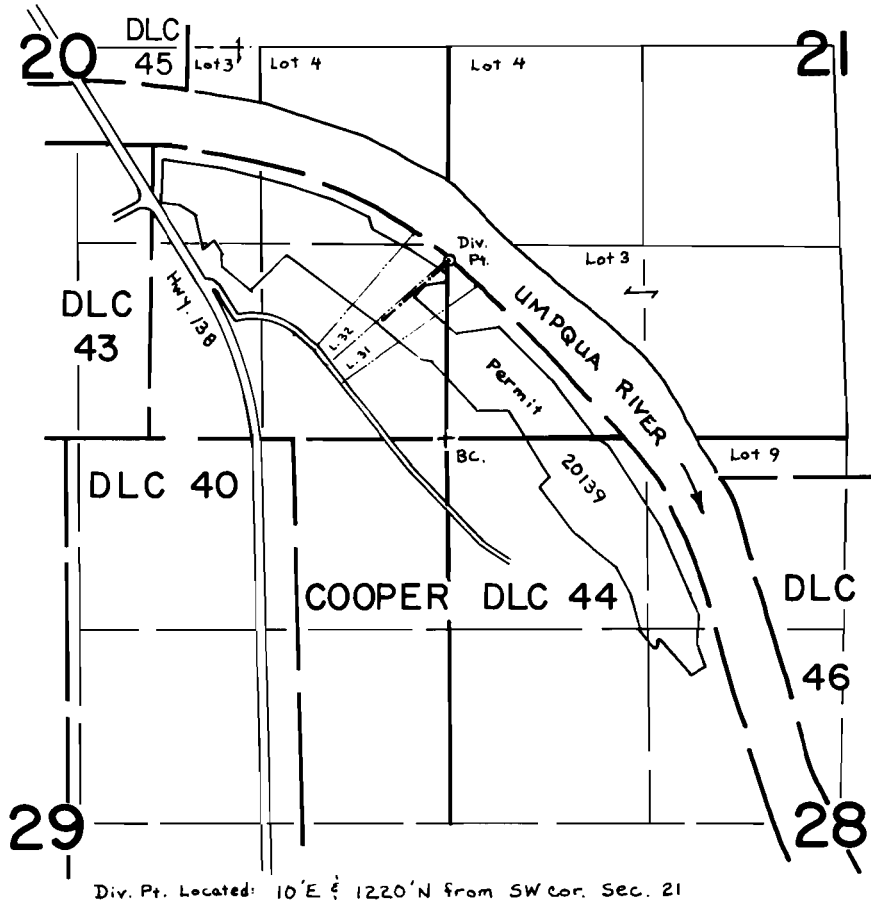

Div. Pt. Located: 10'E & 1220'N from SW Cor. Sec. 21

SCALE: 4" = 1 mile

FINAL PROOF SURVEY
UNDER

Transfer No. 3383

Application No. Permit No.

IN NAME OF

LEWIS F. LAKEY

Surveyed July 28, 1980, by S. Donaldson.....