


T3S. R1E. W1M.

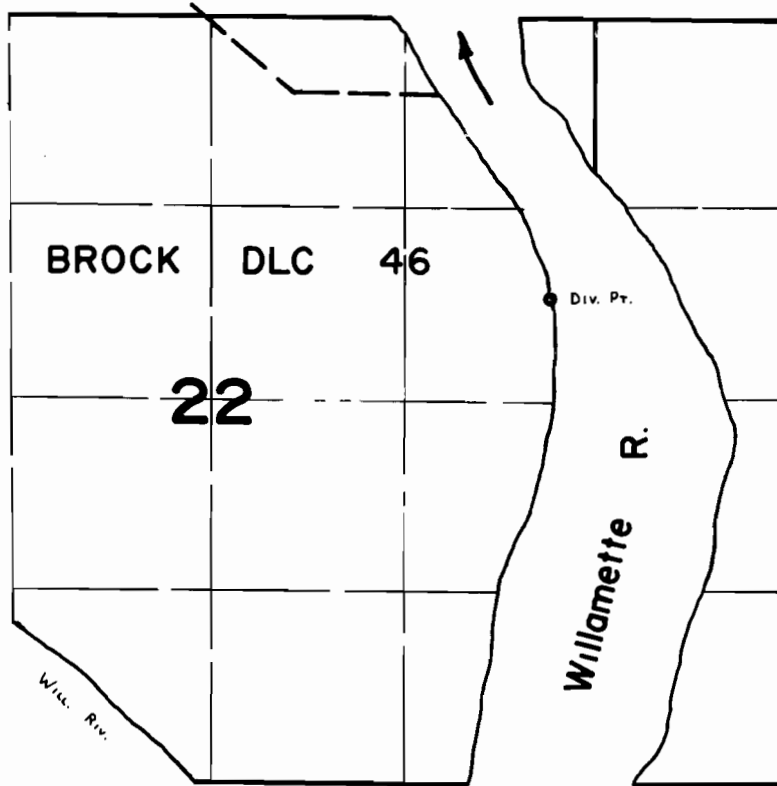

Div. Pt. Loc: 3340' N. & 2325' E. fr. S. 1/4 Cor. Sec. 22.

FINAL PROOF SURVEY UNDER

TRANSFER NO. T-3384

Application No. Permit No.

IN NAME OF

LOWEN K. & ELYNOR K. PANKEY

Surveyed SEPT. 26 1978, by C. L. HUGHES.