

8

T17S, R13E


RECEIVED

APR 5 1968

WATER RESOURCES DEPT.
SALEM, OREGON

18

17

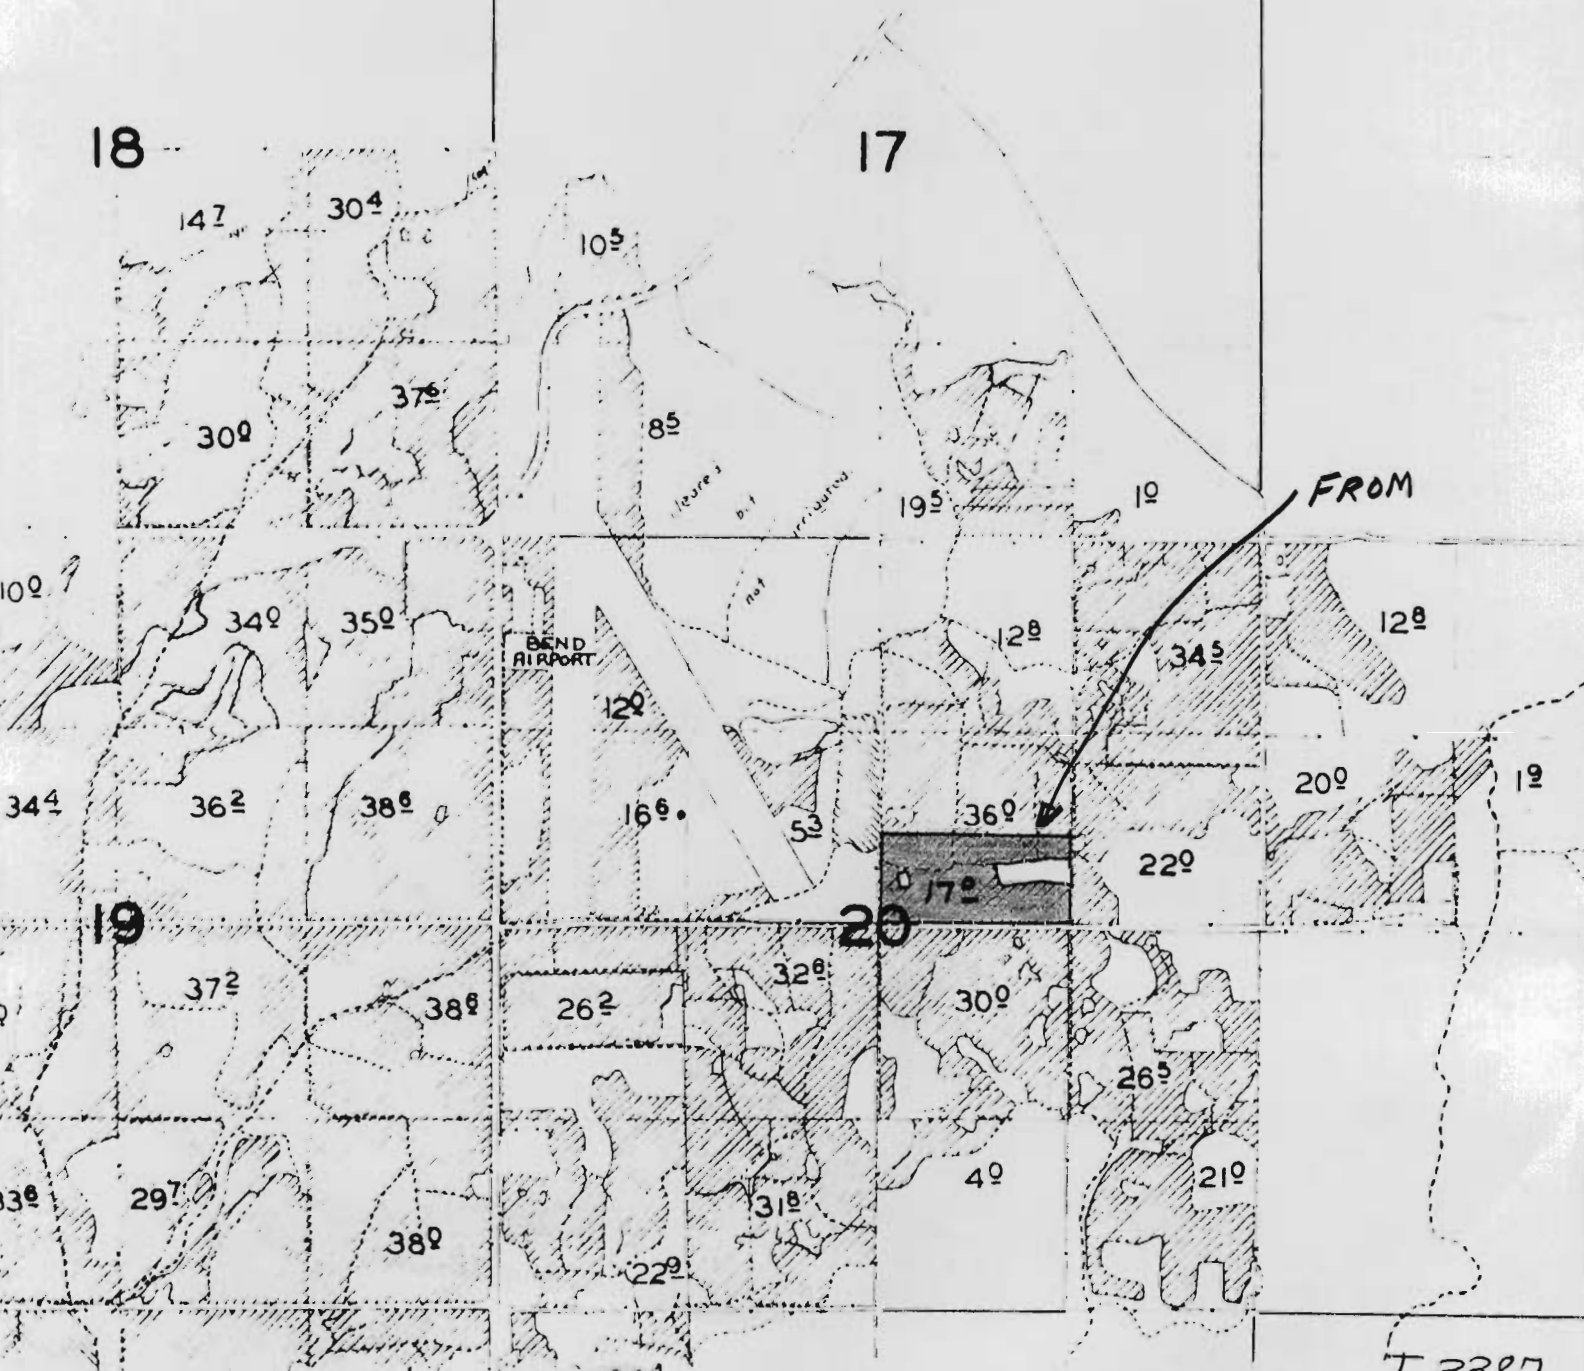

T-3387

7


8

T 17 S, R 13 E


RECEIVED

APR 9 1976

WATER RESOURCES DEPT.
SALEM, OREGON

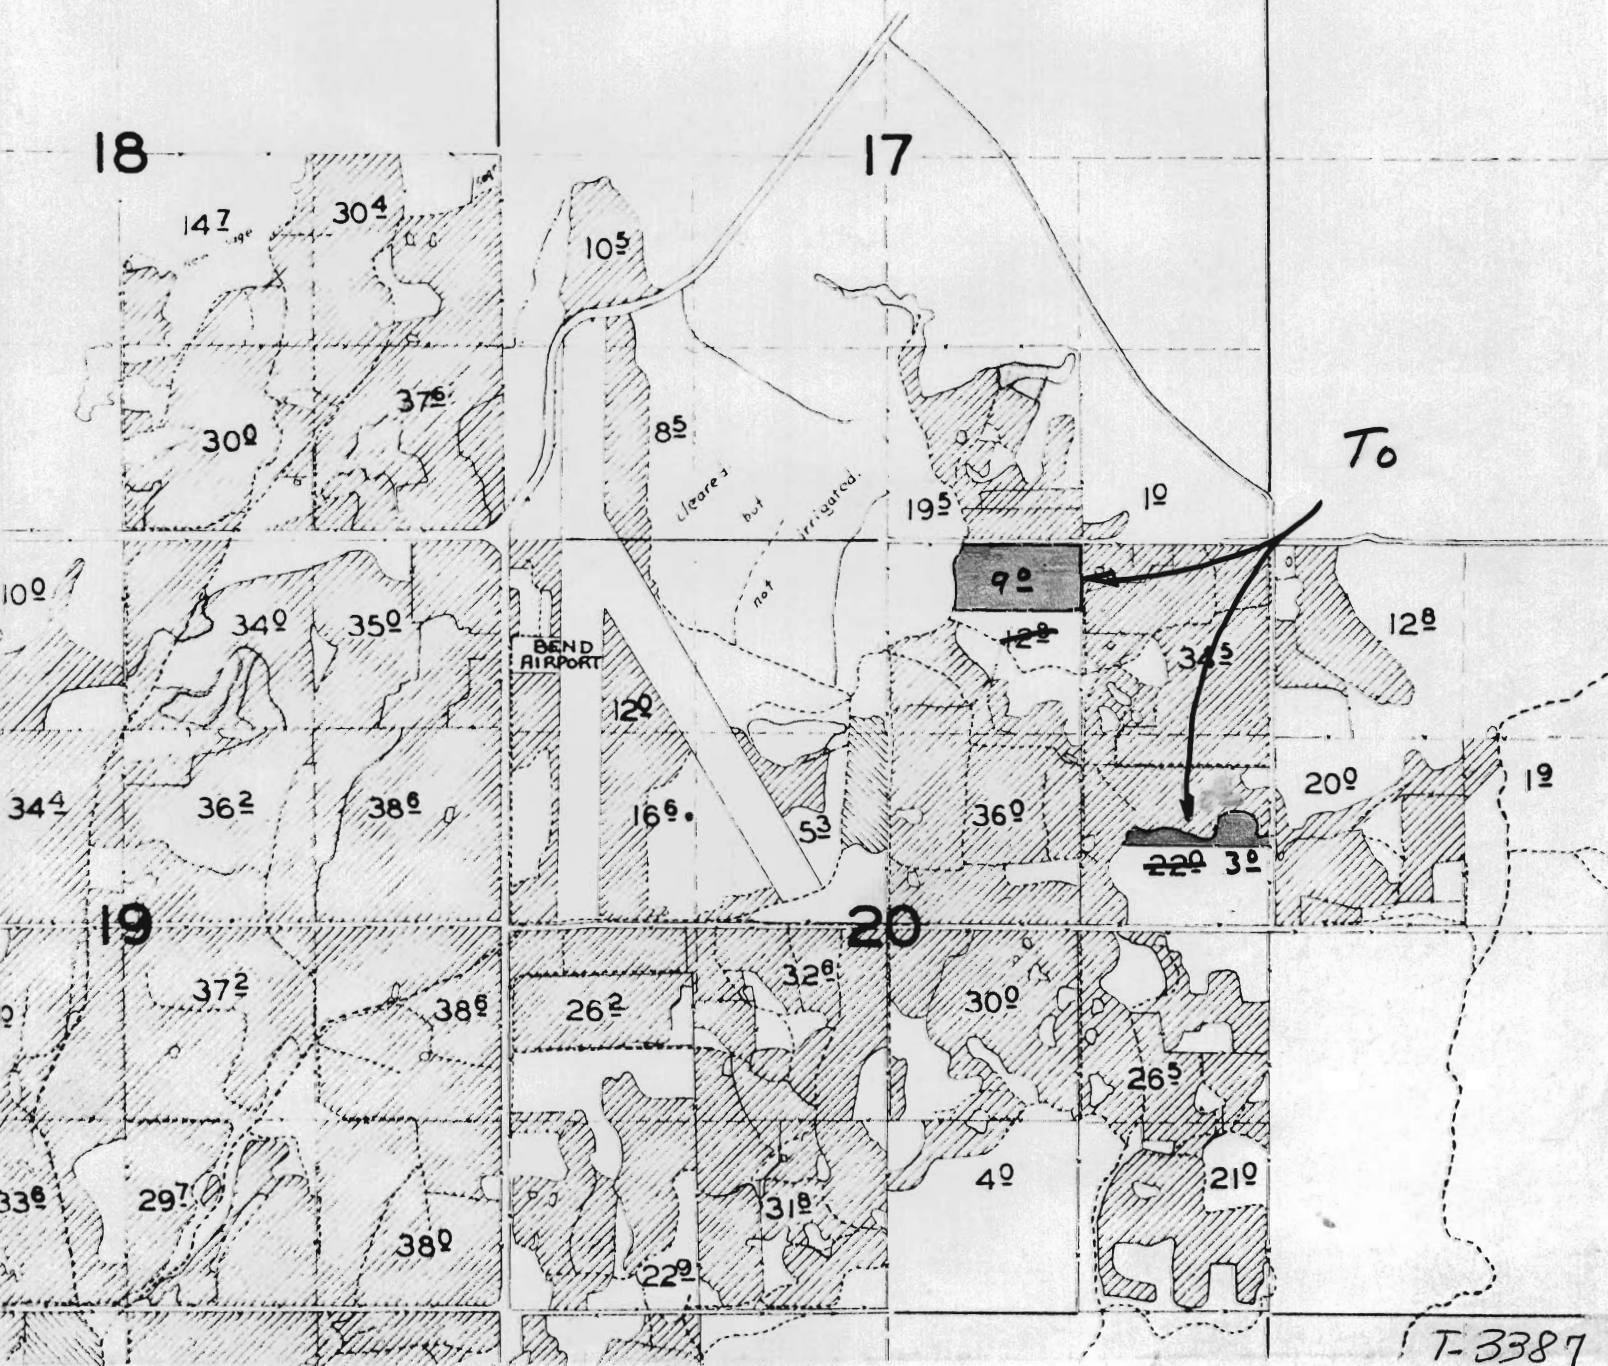

T-3387

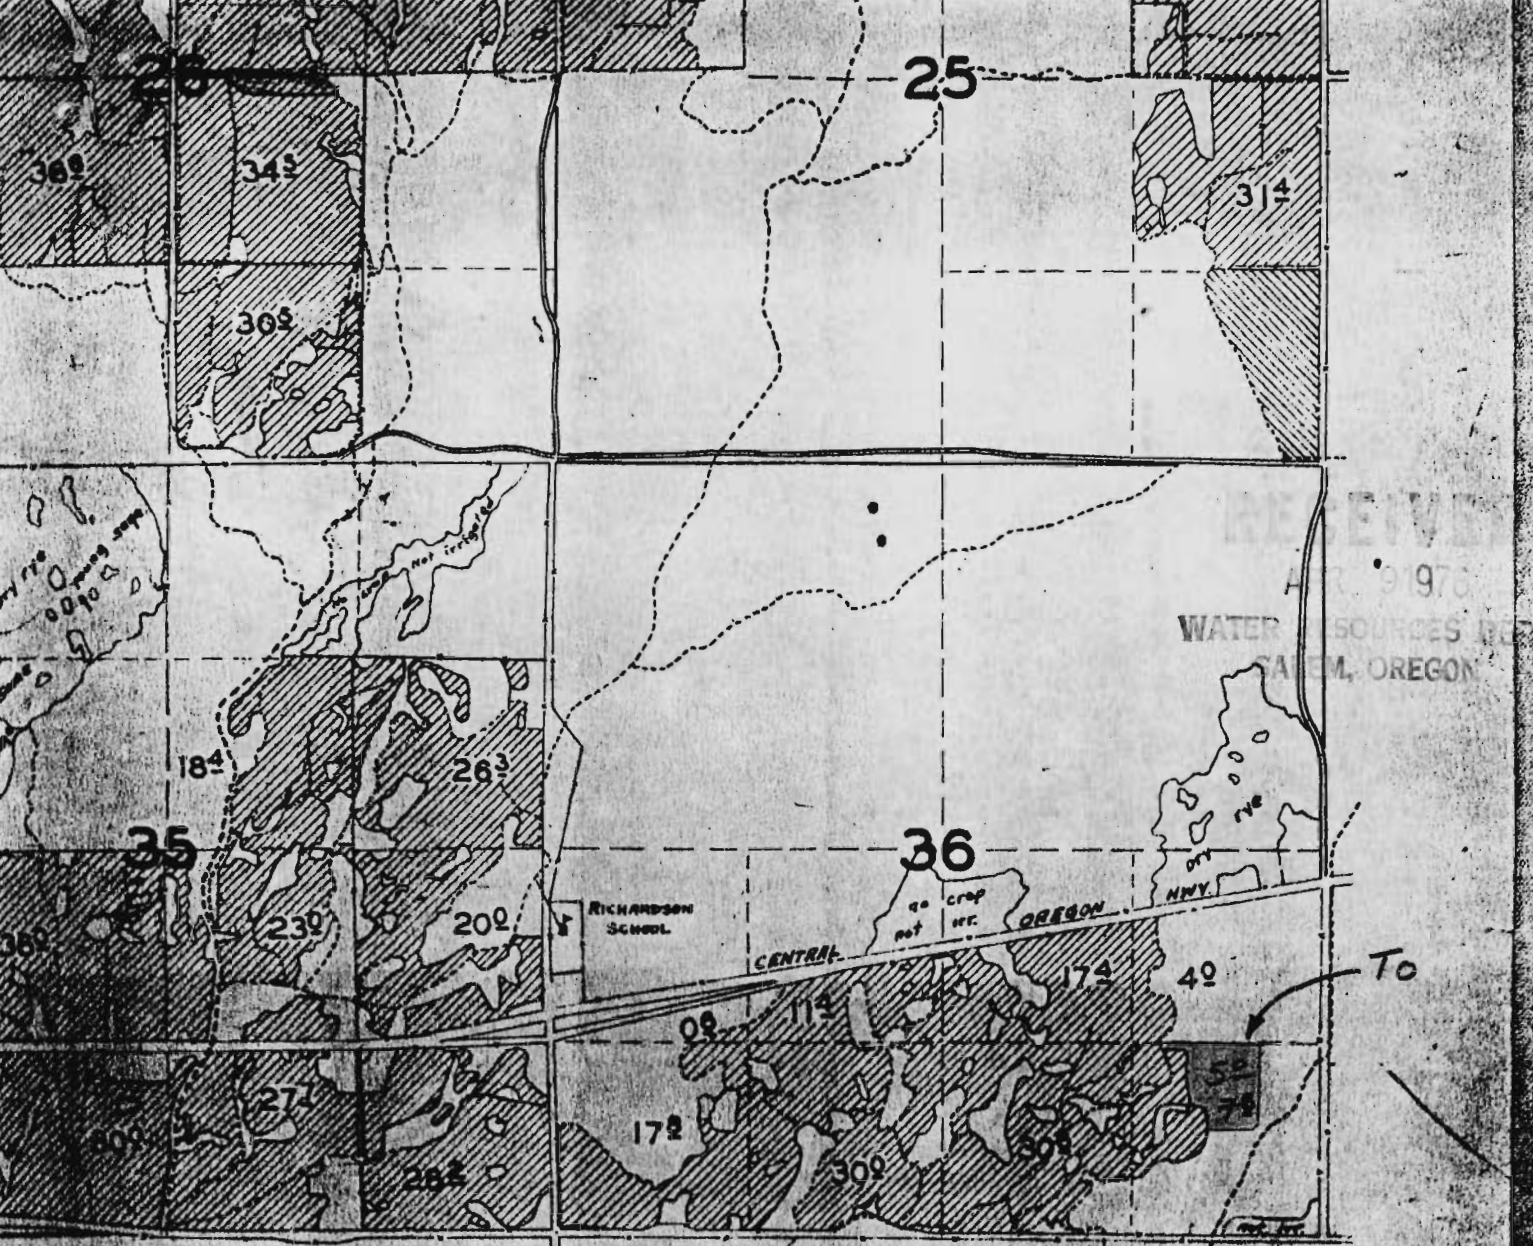

T 17 S, R 12 E

13

... EAST OF DESQUINES RIVER AND JUNE 26 JULY 21 1948

T-3387