


T. 6N. R. 35E. W.M.

WASHINGTON

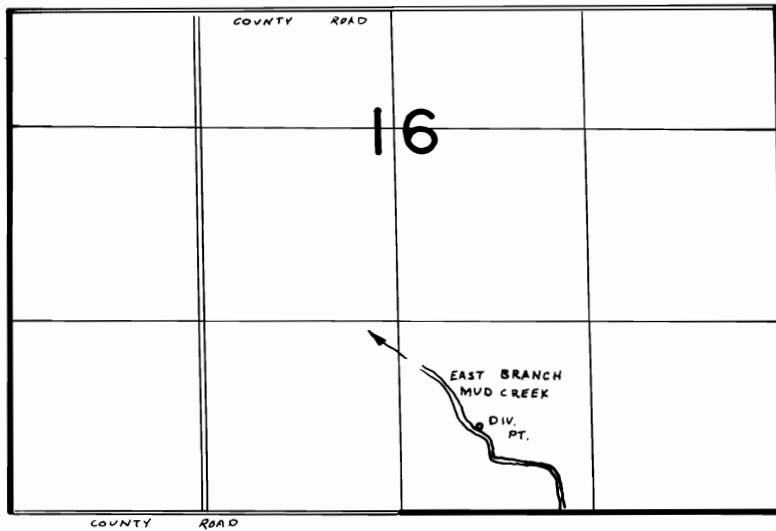

DIV. PT. LOC. 600'N & 2100'W FROM SE COR SEC 16

FINAL PROOF SURVEY
UNDER

TRANSFER 3399

Application No. Permit No.
IN NAME OF

.....**ROY E. WILKINSON**.....

Surveyed 4-10-1978, by R. BARWIN