


T.18S.,R.13E.,WM.

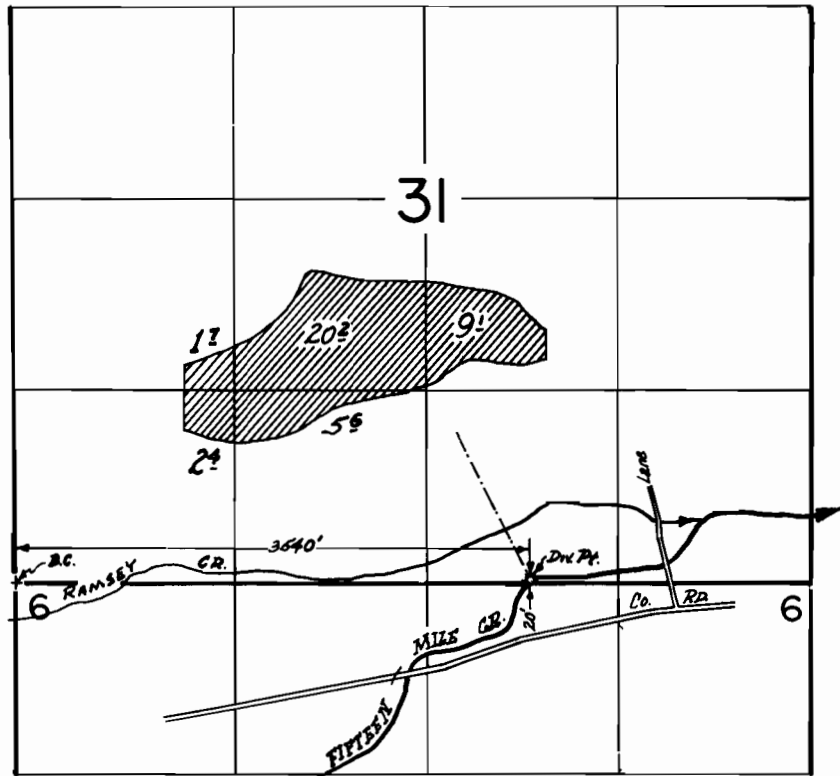

FINAL PROOF SURVEY
UNDER

Transfer No. 3400
Application No. _____ Permit No. _____
IN NAME OF
RICK CANTRELL

Surveyed April 28 1978, by St. Legate