
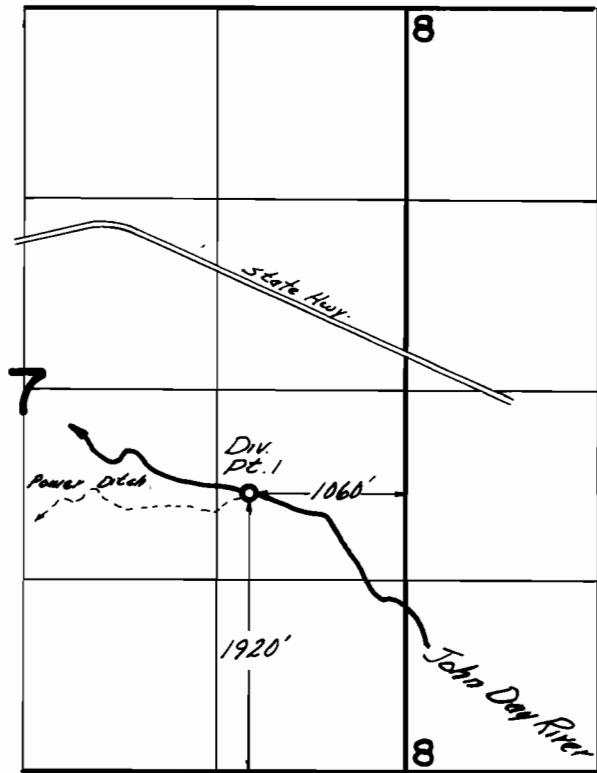


T.13S.R.33E.W.M.

T.13S.R.34E.W.M.

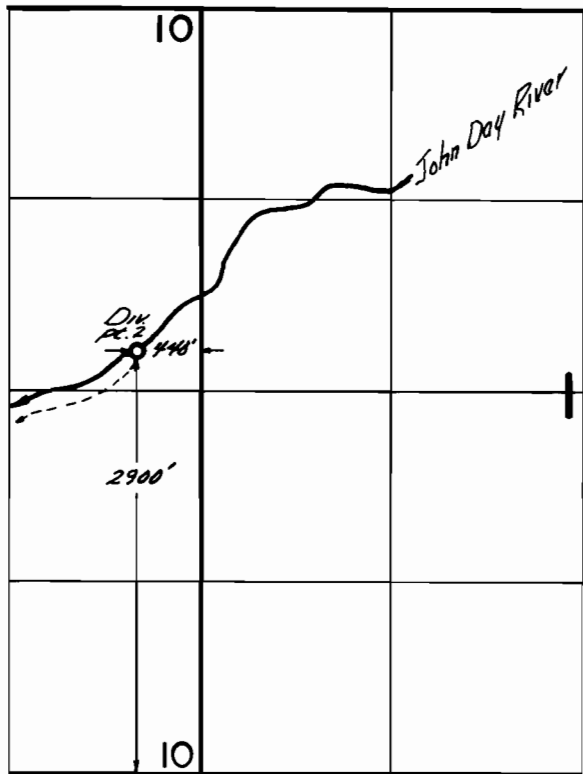

FINAL PROOF SURVEY

UNDER

TRANSFER No....3409 and No. 3410.....
IN NAME OF

.....ELMWOOD RANCH.....

Surveyed Sept...18.. 1979., by S.C.BROWN.....