


T. 39 S., R. 5 W., W.M.

Sec. 3

SW 1/4 NW 1/4

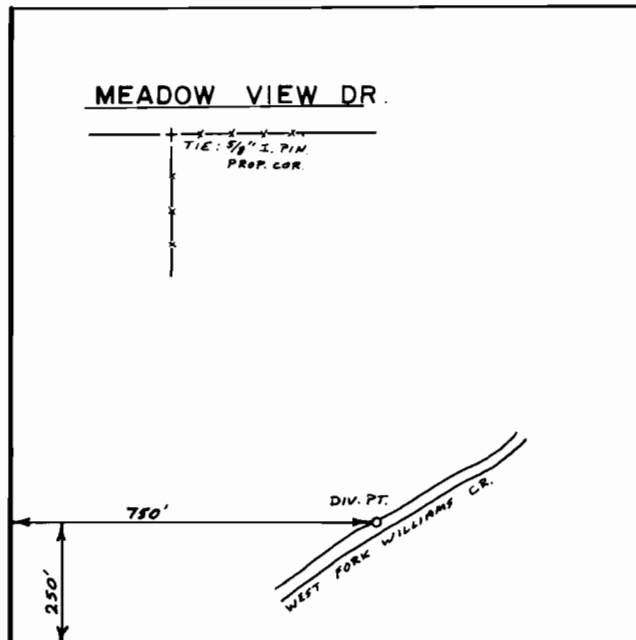

Scale 1" = 400'

FINAL PROOF SURVEY
UNDER

Transfer no. 3411

Application No. Permit No.
IN NAME OF

.....KENNETH A. LUCREZI.....

Surveyed Sept. 30, 1980, by B.R. SUND.....