


T. 23 S. R. 7 W. W. M.

Scale 1" = 1320'

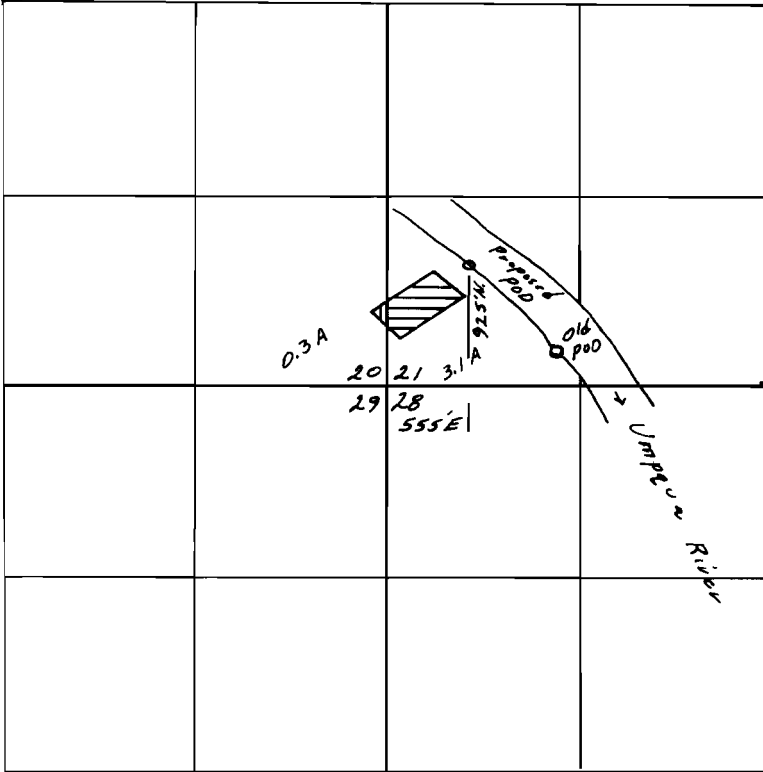

RECEIVED
JUL 1977
WATER RESOURCES DEPT
S. B. GLEASON

THIS MAP PREPARED BY: Francis P. Coppenell
FROM INFORMATION FURNISHED BY THE

T- 3421