


T. 34 S., R. 1 W., W. M.

SEC. 28

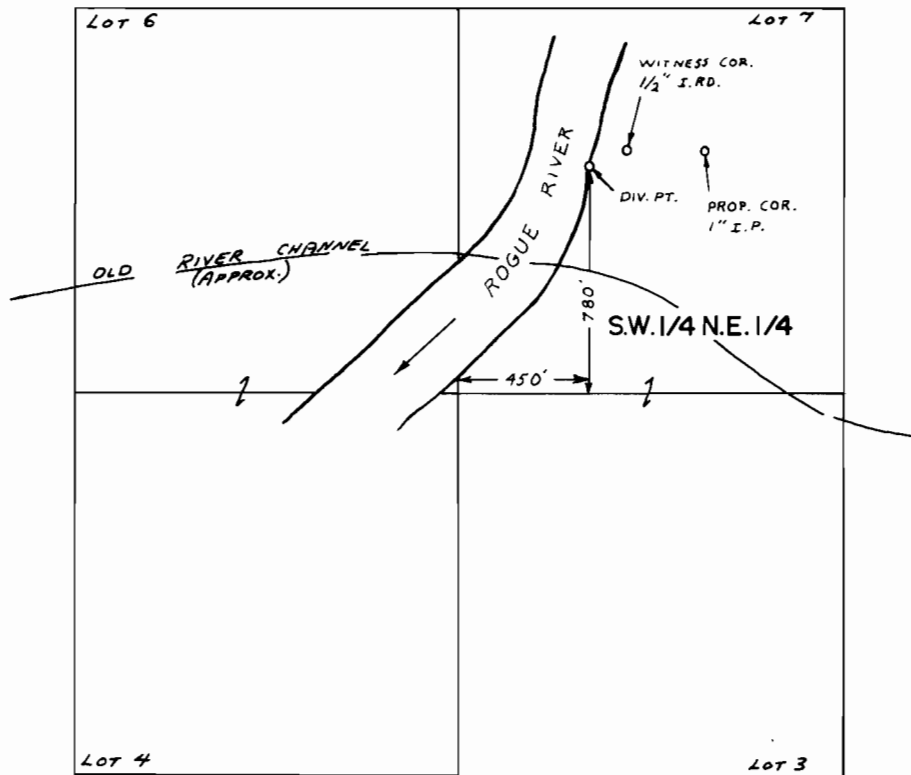

SCALE : 1" = 660 FT.

FINAL PROOF SURVEY
UNDER

Transfer No. 3425

Transfer No. 3426

Application No. Permit No.

IN NAME OF

TRUMAN DEAN & Z. IDELLE COLLINS

Surveyed AUG. 16 1978, by B. SUND