


T. 1 S. R. 48 E. W. M.

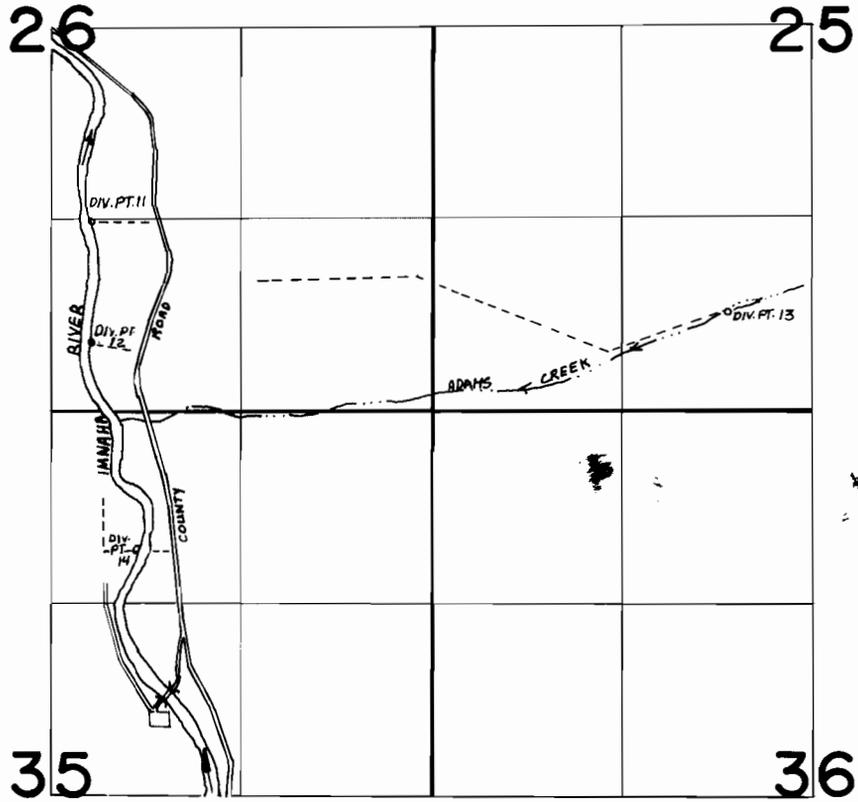

SCALE: 1"=1320'

DIV. PT. 11 LOCATED 1300' N. AND 2360' W. FROM SE. SEC. COR. SEC. 26
 DIV. PT. 12 LOCATED 460' N. AND 2370' W. FROM SE. SEC. COR. SEC. 26
 DIV. PT. 13 LOCATED 770' N. AND 2050' E. FROM S.W. SEC. COR. SEC. 25
 DIV. PT. 14 LOCATED 940' S. AND 2050' W. FROM NE. SEC. COR. SEC. 35

FINAL PROOF SURVEY
 UNDER

TRANSFER 3429
 IN NAME OF

DONALD D. NORTON & GOUCHER

Surveyed Aug. 7, 1924, by V. L. CHURCH