


T. 36 S., R. 2 W., W.M.

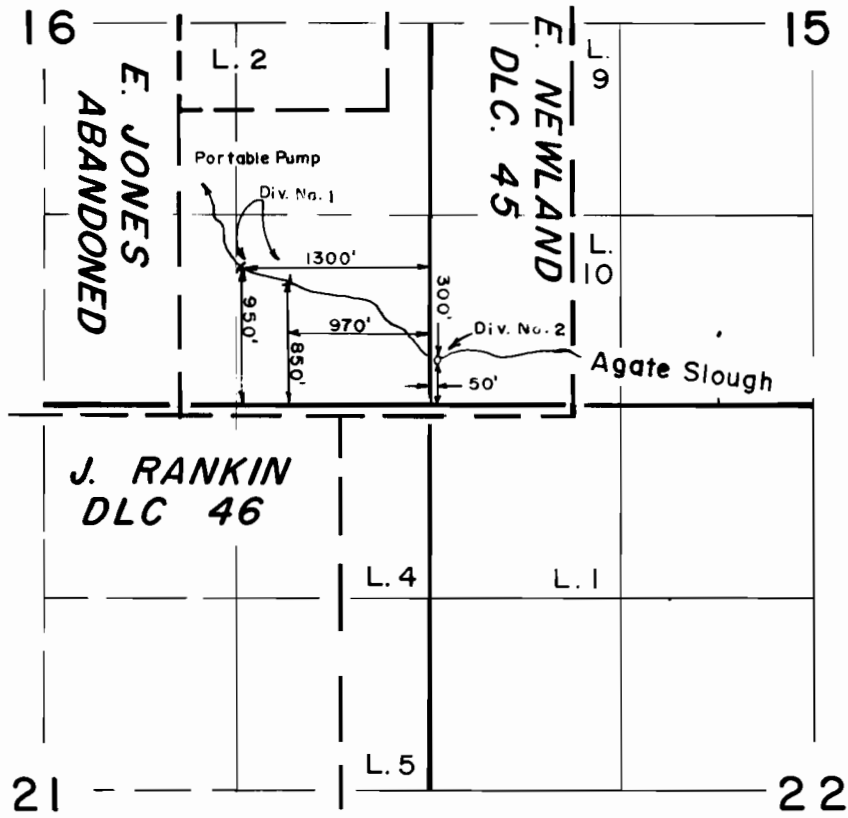

Scale: 1" = 1320'

### FINAL PROOF SURVEY

UNDER

TRANSFERS NO. 3433 & 3434

Application No. .... Permit No. ....  
IN NAME OF

LYNDA...E...SHIELDS...&...ED...KROLOP,

Surveyed MAY 30 1986, by B. S. JAMES