


T. 4S. R. 39E. W.M.

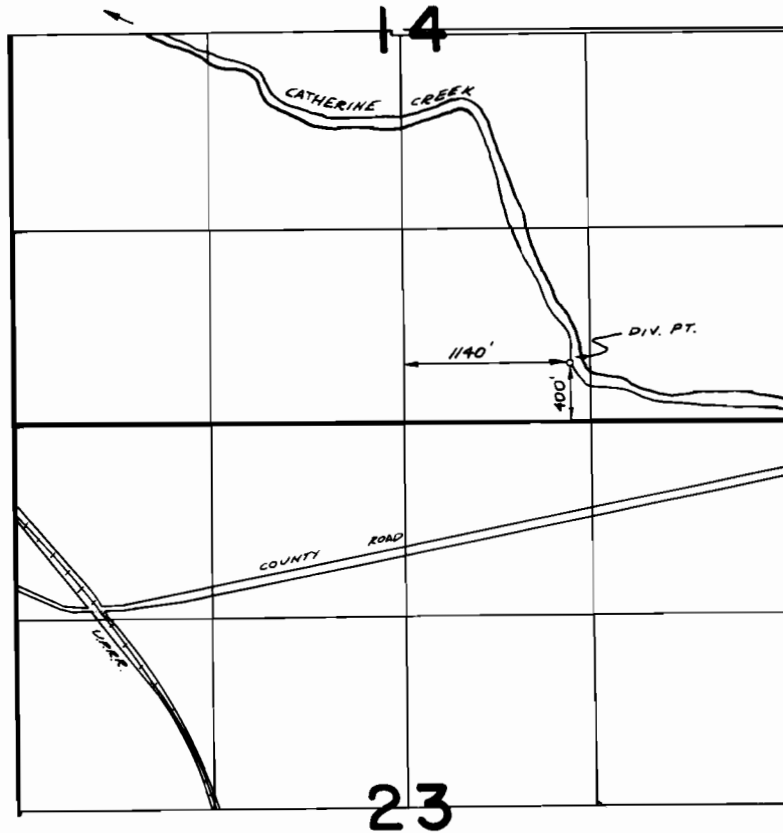

FINAL PROOF SURVEY
UNDER

TRANSFER 3439

Application No. Permit No.
IN NAME OF

.....**ROBERT W. KIMBRO**.....

Surveyed 10-20 1977, by R. BARWIN.....