


T.17S. R.47E. W.M.

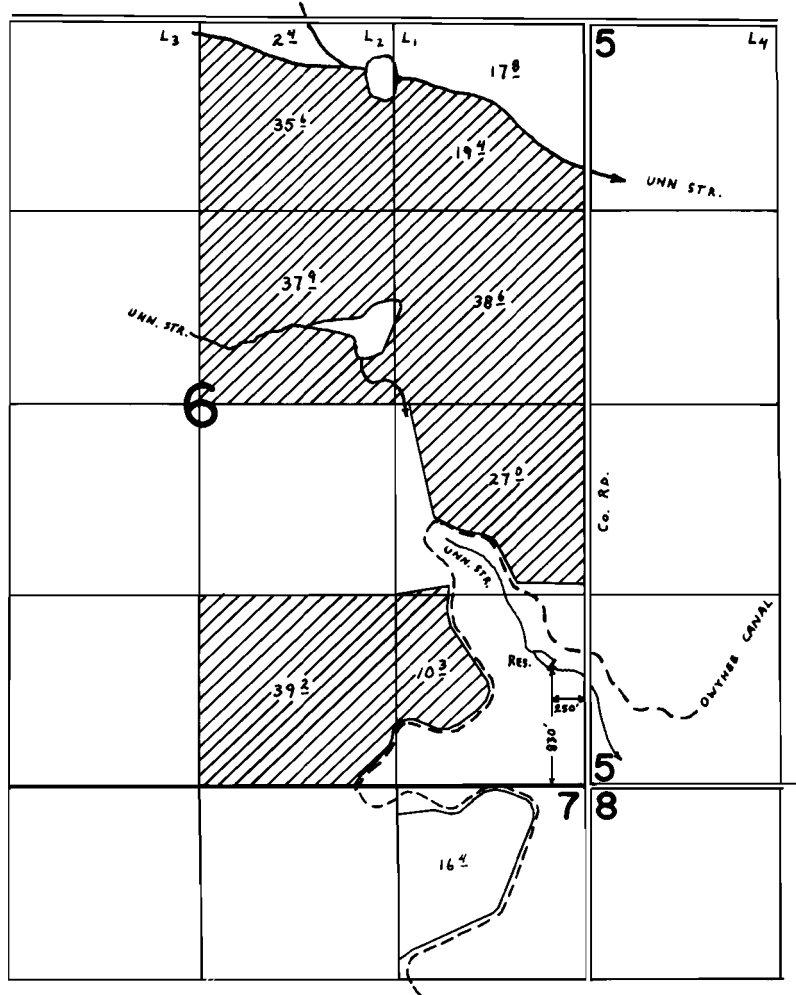

FINAL PROOF SURVEY
UNDER

Transfer No. T-3446
Application No. Permit No.
IN NAME OF

ROBERT W. RUSSELL

Surveyed Aug. 4 19.79, by C. L. HUGHES