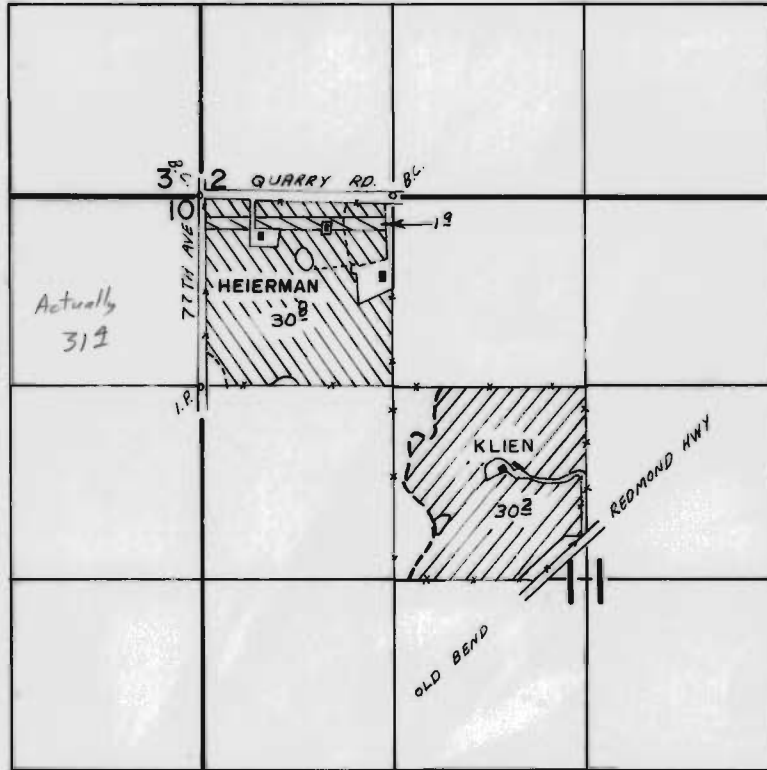
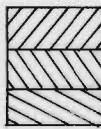

 


T.16S. R.12E. W.M.



 KLEIN PORTION C-170  
 HEIERMAN PORTION C-170  
 3463

**FINAL PROOF SURVEY**  
UNDER

TRANSFER NO. C-170  
3463

Application No. .... Permit No. ....  
IN NAME OF

.... DAN. H. HEIERMAN, SR. & ORVAL KLEIN ...

Surveyed APR. 4, 8, 1980., by L.H. NUNN.....