


T. 35 S., R. 1 W., W.M.

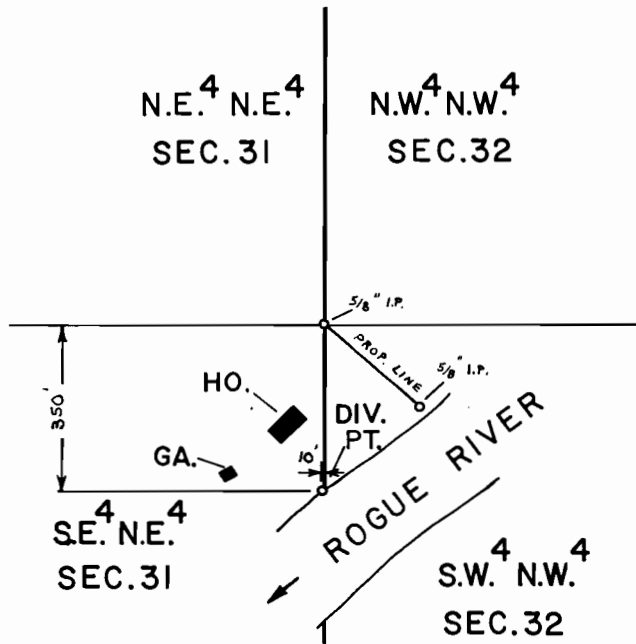

SCALE: 1" = 400 FT.

**FINAL PROOF SURVEY**  
UNDER

Transfer No. 3475

Application No. .... Permit No. ....

IN NAME OF

..... LEON BROWN .....

Surveyed JUN. 22 19 79, by B. SUND .....

D.H.M.

P.T.S. - 1979 - 14 - C