

SW4 NW4

SE4 NW4

SW4 NE4

SNEEL CREEK

NE4 SW4

NW4 SW4

#7  
P.O.D.  
PUMP

SW4SE4

P.O.D.  
#17

SE4 SE4

SPRING CREEK

2300' N 56° E

2400' N 87° E

2260' S 63° E

SE4SW4

#8  
P.O.D.  
PUMP

2160'

22 23  
27 28


NE4NW4

NW4 NE4

NE4NE4

PUMP  
P.O.D.  
#9

7°

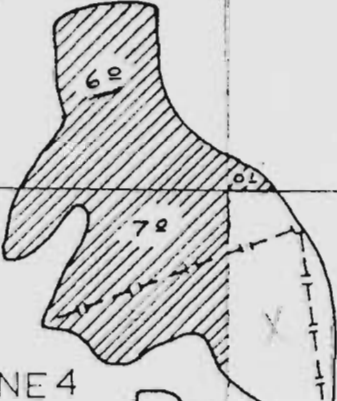

**RECEIVED**

OCT 2 1 1982

WATER RESOURCES DEPT.  
SALEM, OREGON

SE4.NW4

SW4 NE4.

SCHLEUR CREEK

NW4 SE4

NE4 SE4