


# T.18S. R.12E. W.M.

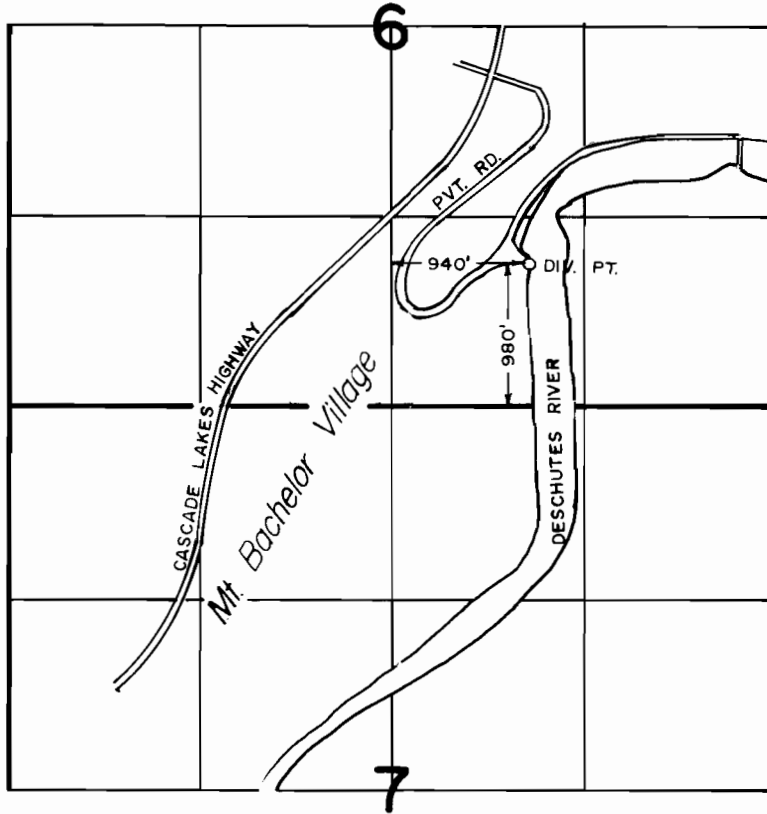

## POINT OF DIVERSION FINAL PROOF SURVEY UNDER

TRANSFER NO. 3477

Application No. .... Permit No. ....  
IN NAME OF

**BROOKS RESOURCES CORP.**

Surveyed MAY 5 1981, by L.H. NUNN