


T. 1 N., R. 2 W., W. M.

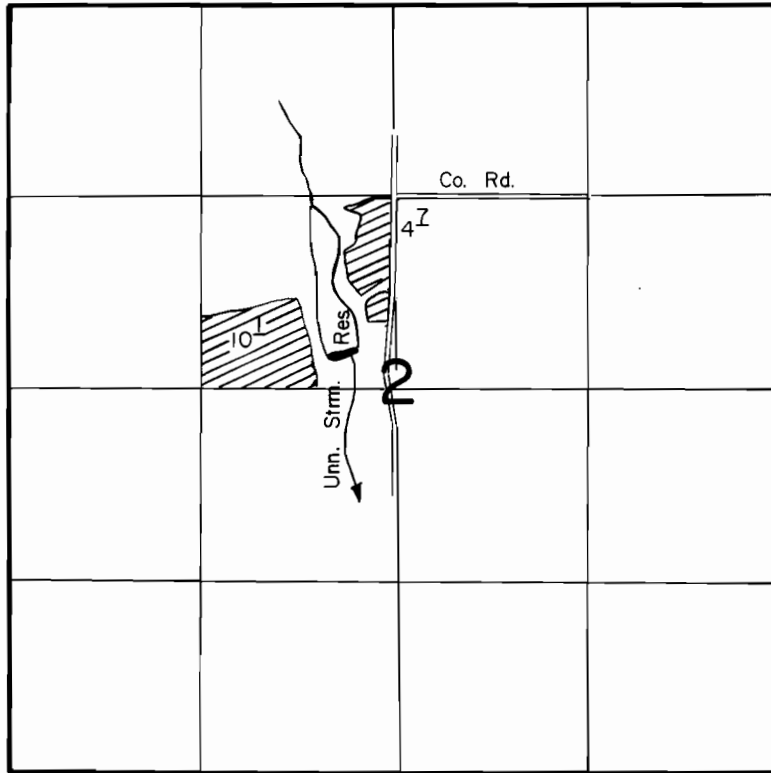

Scale : 1" = 1320'

FINAL PROOF SURVEY

UNDER

TRANSFER 3484

Application No. Permit No.

IN NAME OF

.....FRED BENDER.....

Surveyed March..31.. 1988., by ..J. Warren.....

41067-178-156 B
1/27/89 T.M.W.