


T. 38 S., R.10 & 11 1/2 E., W.M.

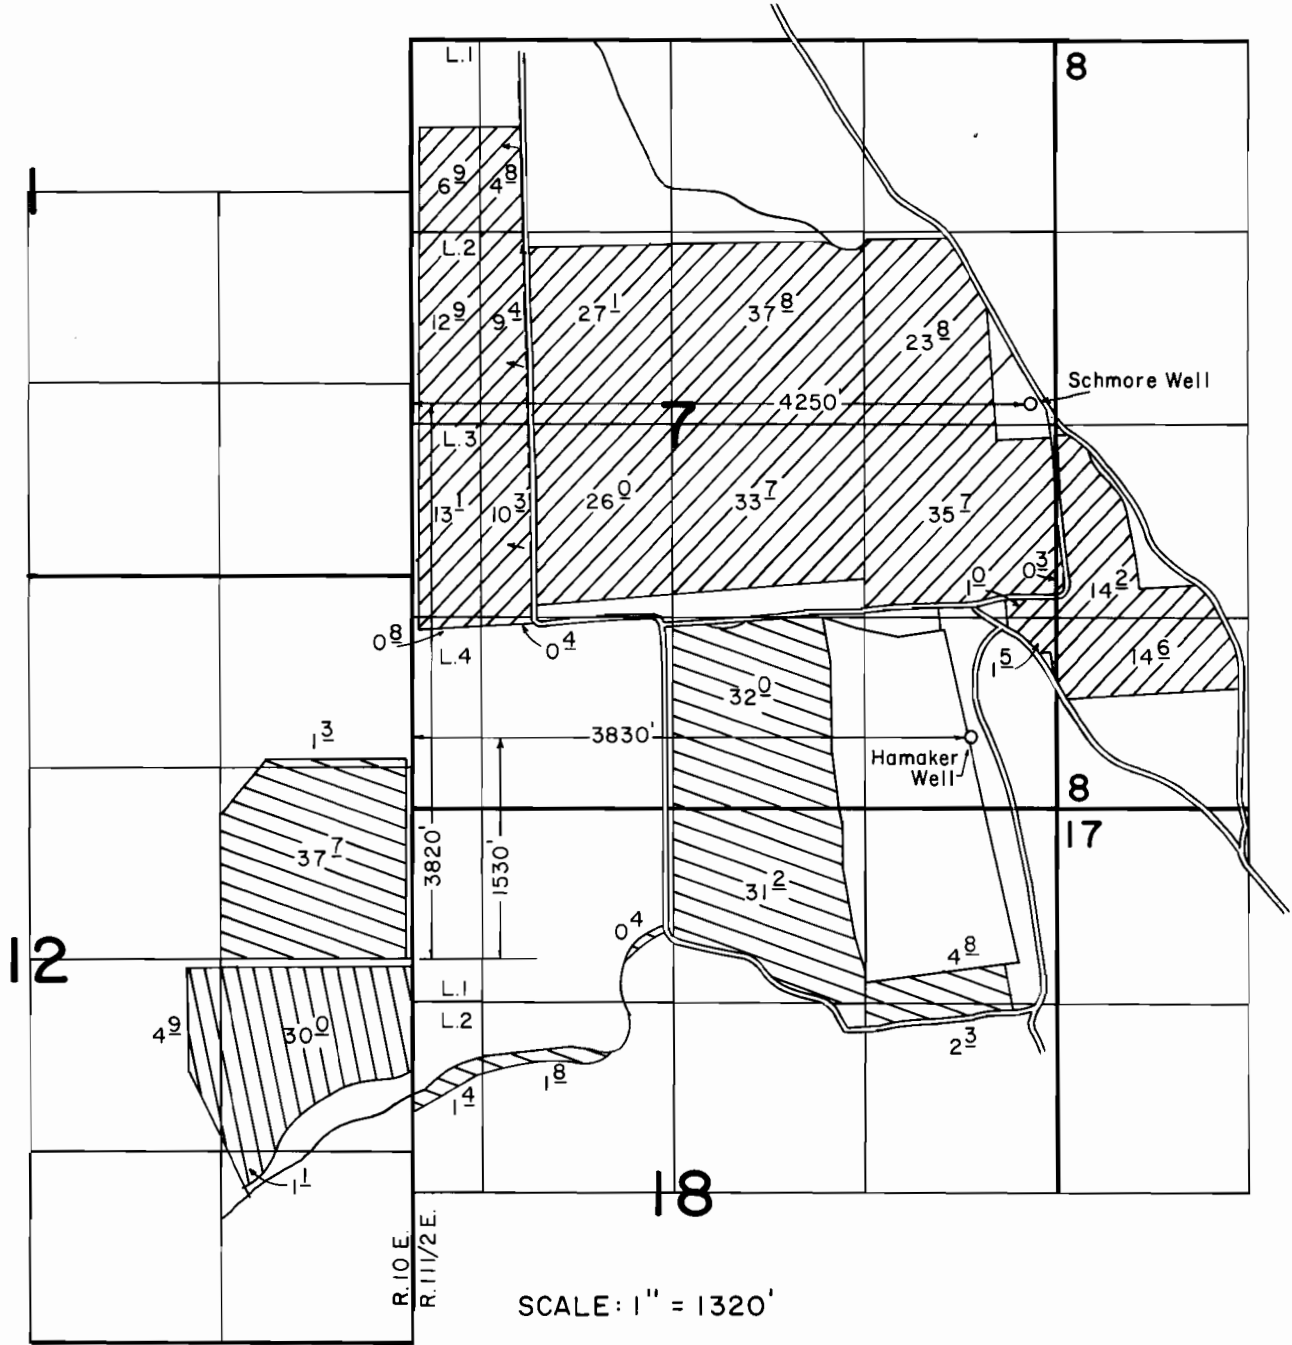

SCALE: 1" = 1320'

FINAL PROOF SURVEY

UNDER
TRANSFER NO. 3486

" " "

Application No. G-7396. Permit No. G-6835
IN NAME OF

C. W. BIAGGI & T. M. VENABLE

Surveyed SEPT. 20 1989, by B. W. BISHOP

- Primary (HAMAKER WELL)
- Supplemental " "
- Primary (SCHMORE WELL)