


T6S.,R.1E.,W.M.

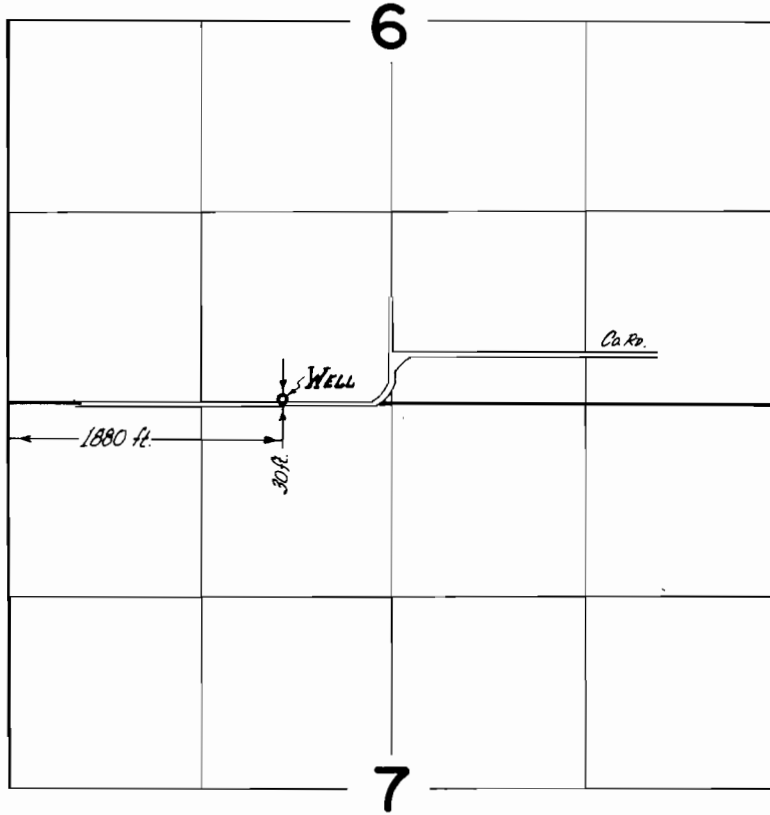

FINAL PROOF SURVEY
UNDER

Transfer No. 3493

Application No. Permit No.

IN NAME OF

HERMAN M. GOSCHIE

Surveyed *Sept. 9* 1977, by *R.G. Mucken*