


T. 36 S., R. 5 W., W. M.

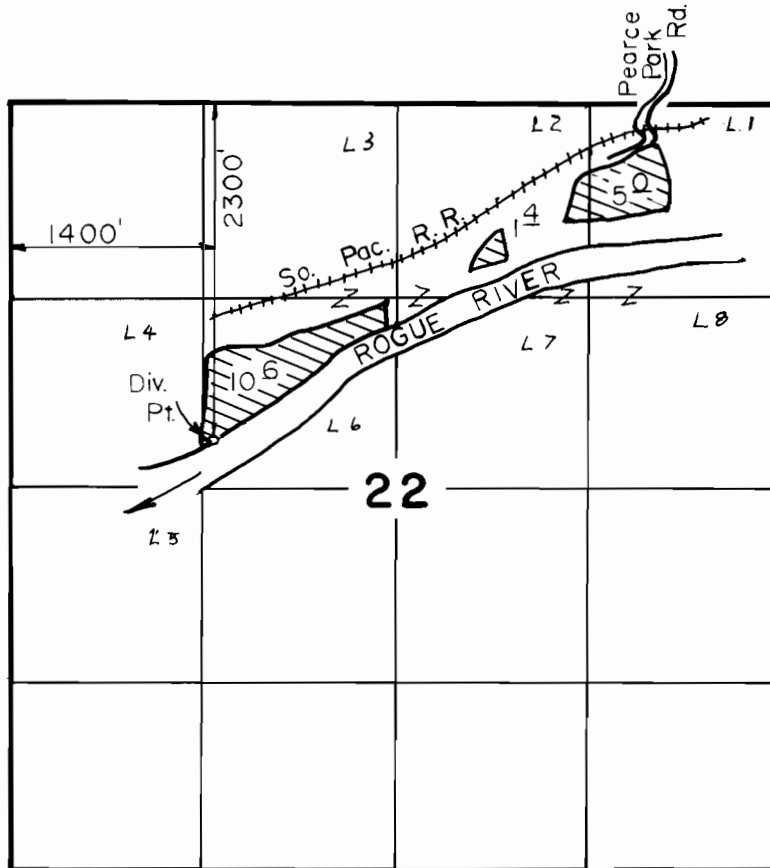

Scale: 1" = 1320'

FINAL PROOF SURVEY
UNDER

TRANSFER NO. 3494

Application No. Permit No.
IN NAME OF

JOSEPHINE CO. PARKS DEPT.

Surveyed JUL...9... 19.87, by .B.:S.....JAMES.