


RECEIVED

DEC - 81976

WATER RESOURCES DEPT  
SALEM, OREGON

SECTION 20 T. 16S. R. 12 E.W.M.

1" = 400'

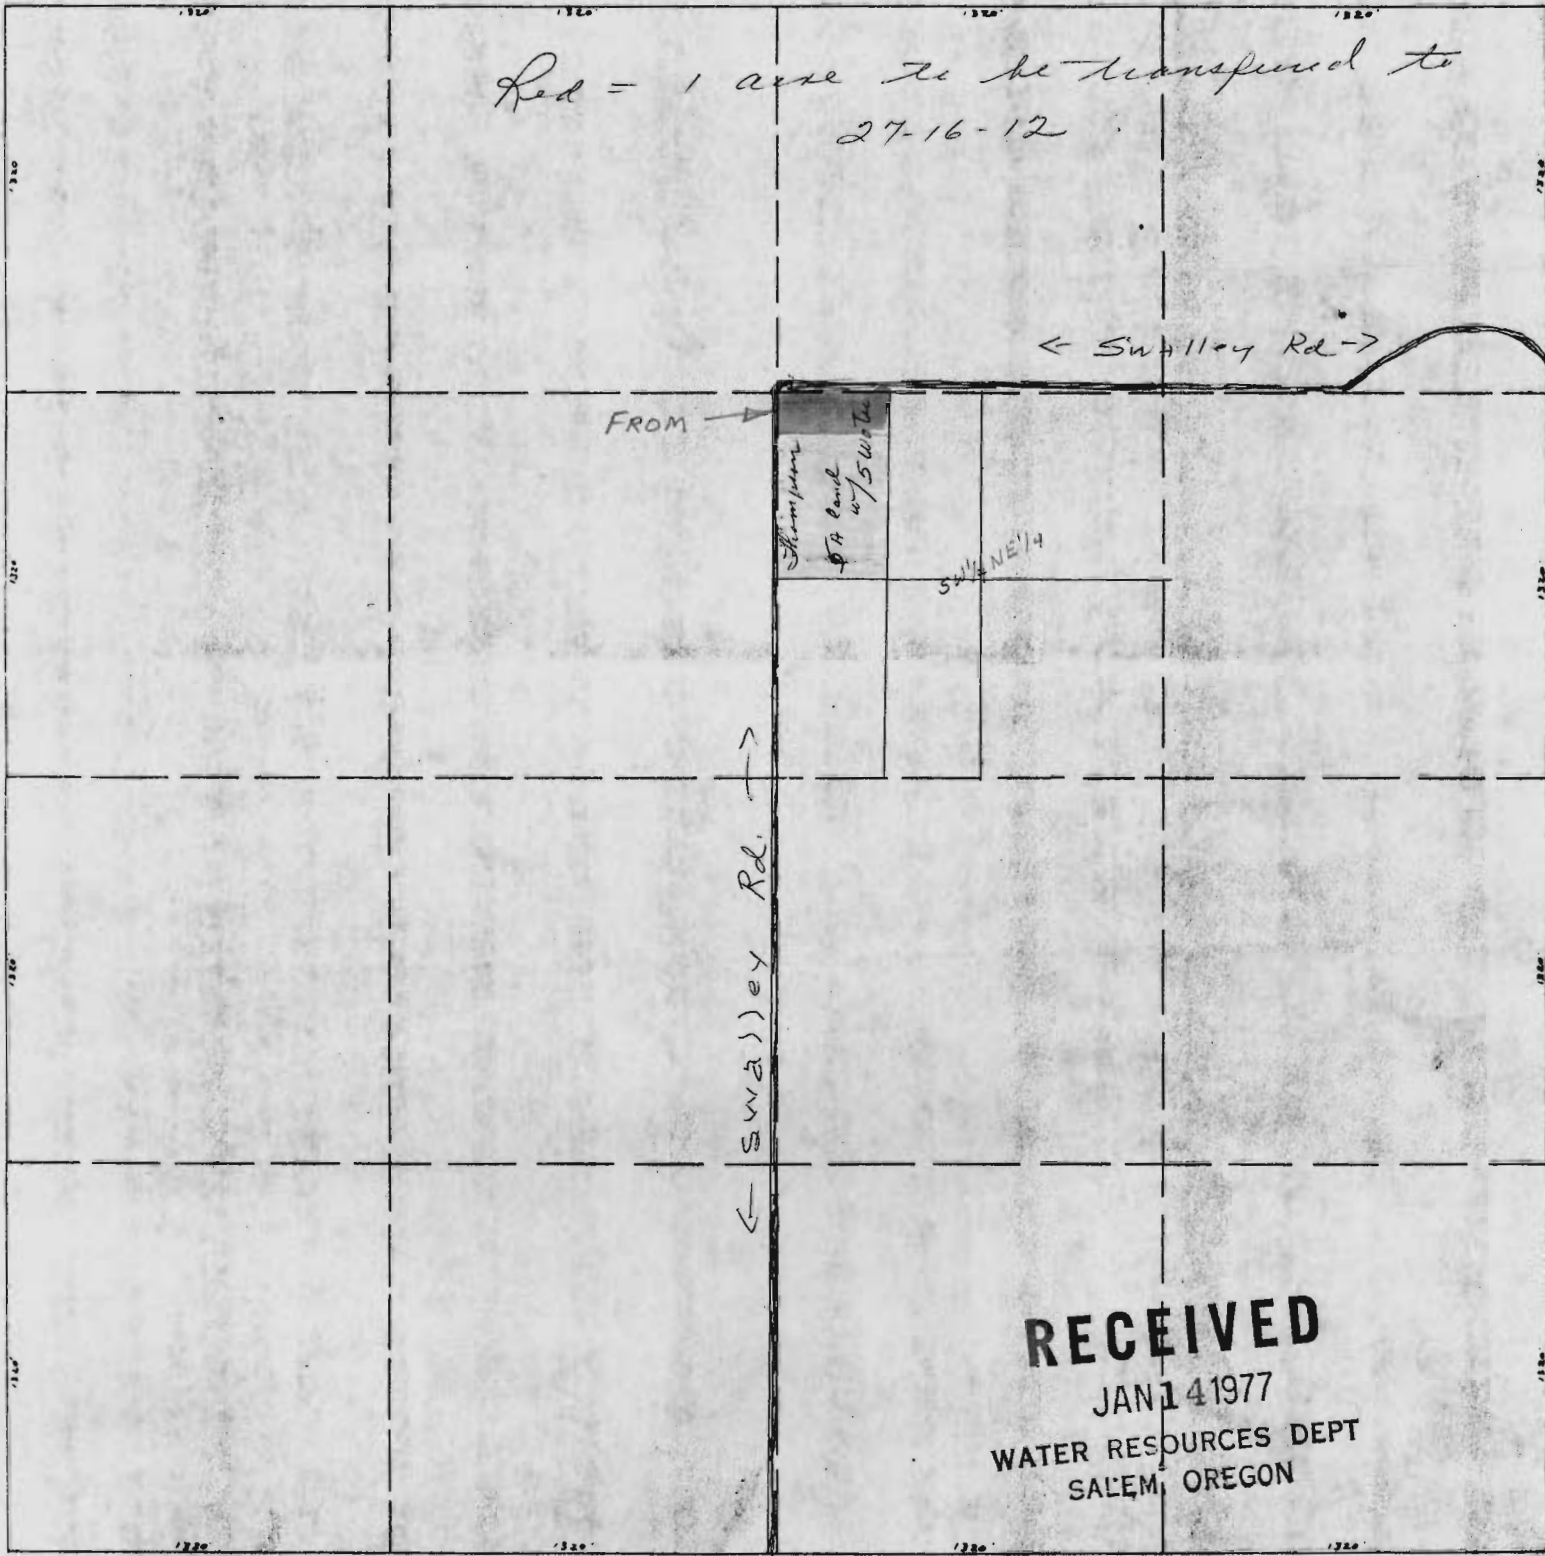

T-2497

SE1/4 SEC. 27 T16S R12E.W1A  
DESCHUTES COUNTY

16 12 27

1"=200'

See Map 16 12 27A

NICHOLS

MARKET ROAD

400

300

200

100

301

\* Existing 20 water  
\* Application to transfer 1A from 20-16-12

2.7

501

1000

1100

12

*Jamison  
2 1/2 land  
w/ 2 water*

*moon  
2 1/2 land  
w/ 1 water*

*Lance  
2 1/2 land  
w/ 2 water*

600

700

500

800

601

1300

DALLAS-CALIFORNIA HWY

RECEIVED

JAN 14 1977

WATER RESOURCES DEPT  
SALEM, OREGON

RECEIVED

DEC - 8 1976

WATER RESOURCES DEPT  
SALEM, OREGON

16 12 27

T-3497