


SCALE - 1" = 660'

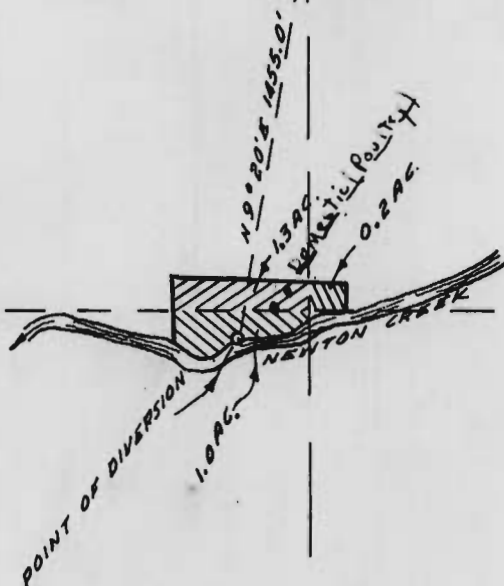

Application No. 33417  
Permit No. 26392

WATER RIGHT  
FOR  
F. W. PRAMANN  
SECTION 14, T. 27 S., R6W. W.M.  
OFFICE OF  
FRED M. DARBY  
COUNTY SURVEYOR, DOUGLAS CO.  
ROSEBURG, OREGON